	- State V	Vell Report	
County: <u>Sunflower</u>		Part 1	For Office Use Only
	Mississippi Department of Environmental Quality		Aquifer:
Permit#: <u>?(?)//(-)</u> Irrigation Equipment	- 1	and Water Resources	Well #: K-116
Driller:	1.0.1	Box 10631	
Date drilling completed: $6-26-06$	-	MS 39289-0631 )961-5210	L. S. Elevation:
Date uniting completed.		54-6938 (fax)	E-log #:
State Law requires that this rep		e driller in detail and filed w	ith the Department wit
30 days of completion of drillin Well Owner Inform		Weil	Location
Owner Name Pitts Farms	)	Latitude: 33, 32,46.	* Longitude:
Mailing Address: 501 Catchi	ngs	Method of Lat/Long (circle on	e): Conventional Survey,
		USGS quad, Hand-held	GPS. Survey-grade GPS
			•••
Indianola	MS 38751	<u>SW14</u> <u>SE</u> 14 <u>Sec</u> 25	Twn 201N Rng 4W
City Sta	ate Zip Code	Distance Direction	Nearest Town
Telephone No. (	51		<u>f_Sunflower</u>
	Well	Data	
Purpose of Well (circle one) Home Ind	Instrial Dublis Country	(Irrigation) Fish Culture	Other, Replaceme
	•••	$\smile$	$\smile$
Date well drilling started: $6-26-$	06 Date	well drilling completed:6	-26-06
If flowing method of flow regulation: Va	iva Other (	4	
If flowing, method of flow regulation: Va $4 > 1$			
Statio Water Levels "J factor			C 2C 2C
Static Water Levelieer at	pove or below (circle one)	land surface Date measured:	6-26-06
Method of Measurement (circle one)	$\sim$		
Method of Measurement (circle one)	teel tape electric tape	air line other:	
Method of Measurement (circle one)	teel tape electric tape	air line other:	
Method of Measurement (circle one)	teel tape electric tape	air line other:	
Method of Measurement (circle one) ( Hole depth: <u>118</u> Well de Type of grout (circle one): Cement	teel tape) electric tape pth: <u>118</u> Bentonite Mix	air line other: Well grouted to a depth of	<u>10</u> fect
Method of Measurement (circle one) Hole depth: <u>118</u> Well de Type of grout (circle one): Cement Casing length: <u>78</u> feet Casin	teel tape electric tape pth: <u>118</u> Bentonite Mix ng diameter: <u>10</u>	air line other: Well grouted to a depth of inches Type of casing:	<u>10</u> feet
Method of Measurement (circle one) Hole depth: <u>118</u> Well de Type of grout (circle one): Cement Casing length: <u>78</u> feet Casin Screen length: <u>40</u> feet Scree	teel tape electric tape pth: 118 Bentonite Mix ng diameter: 10 en diameter: 10	air line other: Well grouted to a depth of inches Type of casing: inches Type of screen:	<u>10</u> feet PVC PVC
Method of Measurement (circle one) Hole depth: <u>118</u> Well de Type of grout (circle one): Cement Casing length: <u>78</u> feet Casin Screen length: <u>40</u> feet Scree	teel tape electric tape pth: 118 Bentonite Mix ng diameter: 10 en diameter: 10	air line other: Well grouted to a depth of inches Type of casing: inches Type of screen:	<u>10</u> feet PVC PVC
Method of Measurement (circle one) Hole depth: <u>118</u> Well de Type of grout (circle one): Cement Casing length: <u>78</u> feet Casin Screen length: <u>40</u> feet Scree Screen slot size: <u>050</u> inches	teel tape electric tape pth: <u>118</u> Bentonite Mix ng diameter: <u>10</u> en diameter: <u>10</u> Setting depth: From _	air line other: Well grouted to a depth of inches Type of casing: inches Type of screen: 79feet to	<u>10</u> fect PVC <u>PVC</u> <u>118</u> feet
Method of Measurement (circle one) Hole depth: <u>118</u> Well de Type of grout (circle one): Cement Casing length: <u>78</u> feet Casin Screen length: <u>40</u> feet Scree Screen slot size: <u>050</u> inches	teel tape electric tape pth: <u>118</u> Bentonite Mix ng diameter: <u>10</u> en diameter: <u>10</u> Setting depth: From _	air line other: Well grouted to a depth of inches Type of casing: inches Type of screen:	<u>10</u> fect PVC <u>PVC</u> <u>118</u> feet
Method of Measurement (circle one) Hole depth: <u>118</u> Well de Type of grout (circle one): Cement Casing length: <u>78</u> feet Casin Screen length: <u>40</u> feet Scree Screen slot size: <u>050</u> inches	teel tape electric tape pth: <u>118</u> Bentonite Mix ng diameter: <u>10</u> en diameter: <u>10</u> Setting depth: From _ Gravel packed Under	air line other: Well grouted to a depth of inches Type of casing: inches Type of screen: 79feet to	<u>10</u> feet PVC <u>118</u> feet sole Natural Developme
Method of Measurement (circle one) Hole depth: <u>118</u> Well de Type of grout (circle one): Cement Casing length: <u>78</u> feet Casin Screen length: <u>40</u> feet Scree Screen slot size: <u>050</u> inches Type of completion (circle all applicable):	teel tape electric tape pth: 118 Bentonite Mix ng diameter: 10 en diameter: 10 Setting depth: From _ Gravel packed Under Other (describe):	air line other: Well grouted to a depth of inches Type of casing: inches Type of screen: 79feet to reamed Telescoped Open I	<u>10</u> feet <u>PVC</u> <u>118</u> feet sole Natural Developme
Method of Measurement (circle one) Hole depth: <u>118</u> Well de Type of grout (circle one): Cement Casing length: <u>78</u> feet Casin Screen length: <u>40</u> feet Scree Screen slot size: <u>050</u> inches Type of completion (circle all applicable): Top of lap pipe or reduction in casing:	teel tape electric tape pth: 118 Bentonite Mix ng diameter: 10 en diameter: 10 Setting depth: From Gravel packed Under Other (describe): feet. If tel	air line other: Well grouted to a depth of inches Type of casing: inches Type of screen: 79feet to reamed Telescoped Open 1	10  feet    PVC
Method of Measurement (circle one) Hole depth: <u>118</u> Well de Type of grout (circle one): Cement Casing length: <u>78</u> feet Casin Screen length: <u>40</u> feet Scree Screen slot size: <u>050</u> inches Type of completion (circle all applicable): Top of lap pipe or reduction in casing:	teel tape electric tape pth: 118 Bentonite Mix ng diameter: 10 en diameter: 10 Setting depth: From Gravel packed Under Other (describe): feet. If tel	air line other: Well grouted to a depth of inches Type of casing: inches Type of screen: 79feet to reamed Telescoped Open 1	10  feet    PVC
Method of Measurement (circle one) Hole depth: <u>118</u> Well define Type of grout (circle one): Cement Casing length: <u>78</u> feet Casin Screen length: <u>40</u> feet Scree Screen slot size: <u>050</u> inches Type of completion (circle all applicable): Top of lap pipe or reduction in casing: Logs run (circle all applicable): No log run Name of organization running log(s):	teel tape electric tape pth: 118 Bentonite Mix ng diameter: 10 en diameter: 10 Setting depth: From Gravel packed Under Other (describe): feet. If tel n Electric Gamma Ray	air line other: Well grouted to a depth of inches Type of casing: inches Type of screen: 79feet to reamed Telescoped Open I lescoped or more than one scree Density Sonic Neutron O	10  feet    PVC
Method of Measurement (circle one) Hole depth: <u>118</u> Well de Type of grout (circle one): Cement Casing length: <u>78</u> feet Casin Screen length: <u>40</u> feet Scree Screen slot size: <u>050</u> inches Type of completion (circle all applicable): Top of lap pipe or reduction in casing: Logs run (circle all applicable): No log run <u>Name of organization running log(s):</u> I certify that the well was drilled, constr	teel tape electric tape pth: 118 Bentonite Mix ng diameter: 10 en diameter: 10 Setting depth: From Gravel packed Under Other (describe): feet. If tel h Electric Gamma Ray ucted, and completed in a	air line other: Well grouted to a depth of inches Type of casing: _H inches Type of screen: 79feet to reamed Telescoped Open H lescoped or more than one scree Density Sonic Neutron O	10  feet    PVC
Method of Measurement (circle one) Hole depth: <u>118</u> Well define Type of grout (circle one): Cement Casing length: <u>78</u> feet Casin Screen length: <u>40</u> feet Scree Screen slot size: <u>050</u> inches Type of completion (circle all applicable): Top of lap pipe or reduction in casing: Logs run (circle all applicable): ho log run <u>Name of organization running log(s):</u> I certify that the well was drilled, construe Department of Environmental Quality a	teel tape electric tape pth: 118 Bentonite Mix ng diameter: 10 en diameter: 10 Setting depth: From Gravel packed Under Other (describe): feet. If tel n Electric Gamma Ray ucted, and completed in a nd/or the Mississippi Dep	air line other: Well grouted to a depth of inches Type of casing: _H inches Type of screen: 79feet to reamed Telescoped Open H lescoped or more than one scree Density Sonic Neutron O	10  feet    PVC
Method of Measurement (circle one) Hole depth: <u>118</u> Well defined Type of grout (circle one): Cement Casing length: <u>78</u> feet Casin Screen length: <u>40</u> feet Scree Screen slot size: <u>050</u> inches Type of completion (circle all applicable): Top of lap pipe or reduction in casing: Logs run (circle all applicable): No log run <u>Name of organization running log(s):</u> I certify that the well was drilled, construe Department of Environmental Quality a Irrigation Equipment	teel tape electric tape pth: 118 Bentonite Mix ng diameter: 10 en diameter: 10 Setting depth: From Gravel packed Under Other (describe): feet. If tel n Electric Gamma Ray ucted, and completed in a nd/or the Mississippi Dep ent Inc.	air line other: Well grouted to a depth of inches Type of casing: _H inches Type of screen: 79feet to reamed Telescoped Open H lescoped or more than one scree Density Sonic Neutron O	10  feet    PVC
Method of Measurement (circle one) Hole depth: <u>118</u> Well define Type of grout (circle one): Cement Casing length: <u>78</u> feet Casin Screen length: <u>40</u> feet Scree Screen slot size: <u>050</u> inches Type of completion (circle all applicable): Top of lap pipe or reduction in casing: Logs run (circle all applicable): ho log run <u>Name of organization running log(s):</u> I certify that the well was drilled, construe Department of Environmental Quality a	teel tape electric tape pth: 118 Bentonite Mix ng diameter: 10 en diameter: 10 Setting depth: From Gravel packed Under Other (describe): feet. If tel n Electric Gamma Ray ucted, and completed in a nd/or the Mississippi Dep	air line other: Well grouted to a depth of inches Type of casing: _H inches Type of screen: 79feet to reamed Telescoped Open H lescoped or more than one scree Density Sonic Neutron O	10  feet    PVC

JUL 102006 BY: OLM R If well telescopes please sketch below and show depths.


Old Well 10' East

Ground Level

Description of Formations Encountered	From To
Clay	0 21
Fine Sand Fine Sand/gravel	22 55
Fine Sand/gravel	56 75
Med. Sand/gravel	/6 115
Clay	116118
-	
	╾┼╌╾┼╶─┤
	-+
	-+

K- 1

If more than one screen, show location of each on sketch

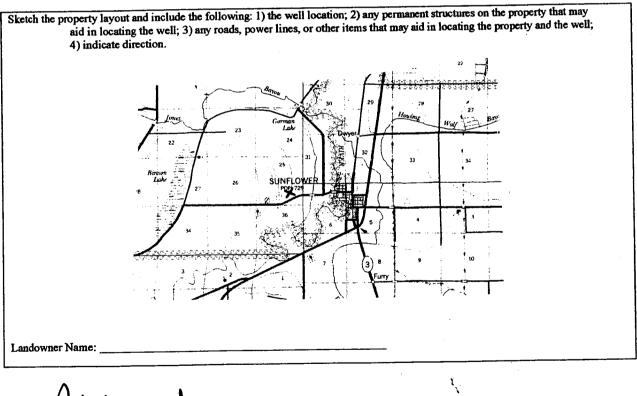

Signature of Water Well Contractor

STATE WELL REPORT				
County: Sunflower	Part 2	For Office Use Only:		
Permit #: 610 4116	Pump Installer's Completion Report Mississippi Department of Environmental Quality	Aquifer:		
Irrigation Equipme Driller	nt Office of Land and Water Resources P.O. Box 10631			
Date completed: $6-26-06$	Jackson, MS 39289-0631 (601)961-5210	Well #: 116		
Convinformation from block on Part 1	(601)354-6938 (fax)	Elevation:		

This part of the report must be completed by a licensed water well contractor or a licensed pump installer. A copy of Part 1 of the report must be attached and both parts filed with the Department at the above address within 30 days of well completion.

Well Owner Information	wen Location
Owner Name: Pitts Farms	Latitude:Longitude:
Mailing Address: 501 Catchings	Method of Lat/Long (check one): Conventional Survey,
	USGS quad, Hand-held GPS, Survey-grade GPS
Indianola MS 38	751 SW 4 SE 4 Sec 25 T 20N R 4W
City State Zip	Code
662-887-4551	Distance Direction Nearest Town
Telephone No. ( )	2 <sub>Miles</sub> West of Sunflower

Pump Type Circle one		Power Type Circle one			
Air Lift	Jet	Submersible	Diesel Engine	Gasoline Engine	Natural Gas
Bucket	Piston	Turbine	Electric Motor	Hand	Tractor PTO
Centrifugal	Rotary	Flowing Well	Windmill	Other (specify):	
Other (specify):			Horse Power Ratin	g of Motor:15	
Date Pump Installed:	6-26-06		Setting Depth:	70	feet
Rated Pump Capacity:	750	_Gallons Per Minute	Number of Stages:	1	

Pump Test Data	Method of Measuring Water Level Circle one		
Date Well Tested:			
Static Water Level (A):Feet Below Land Surface	Air Line Electric Measuring Line Steel Tape		
	Other (specify):		
Pumping Water Level (B):Feet Below Land Surface			
Drawdown [(B) - (A)]:Feet Below Land Surface	For flowing well, measured shut in head: feet		
Test Pumping Rate:Gallons Per Minute	Well yielded GPM with a drawdown of		
Duration of Pump Test (minimum 4 hours):hours	feet afterhours of pumping		

I HEREBY CERTIFY that the above statements are true to the best	of my knowledge.	
Patrick M. Chism 0695	Patril M. Chu	nenewen
Print Name of Pump Installer and License No. (if applicable)	Signature of Pump Installer	The bar Bar & Are Bar
	I	-orm: OLWR-SWR-18
		BYCOLWA