	State Well R	eport	
county: Sunflower	Part 1	For Office Use Only:	:
	Mississinni Department of Emvironmental Auglity		
Permit #: 6W41757	<u>66041757</u> Mississippi Department of Environmental Quality Office of Land and Water Resources		1
Permit #: <u>6004/757</u> Irrigation Equipment Driller:	P.O. Box 106	31 Well #: $(-70)^{-7}$	
4 12.07	Jackson, MS 3928		
Date drilling completed:	(601)961-521		
	(601)354-6938	[IAX] E-log #:	
State Law requires that this repo 30 days of completion of drilling		in detail and filed with the Department with	nin
Well Owner Informa	tion	Well Location	
Owner Name Pitts Farms		le: 33, 32, 44, 1 90, 35, 4 50	29,
Mailing Address: BOX 925		Method of Lat/Long (circle one): Conventional Survey, 29	
	1	ISGS quad, Hand-held GPS, Survey-grade GPS	_
Tradianole	L MS 38751 NE	1/4 SE 1/4 Sec 27 Twn 20 N Rng 4	W
<u>Indianola MS 38751</u> City State ZipCode Telephone No. (662-887-4551		ce Direction Nearest Town	
10102-881-0	4551 - 3	Miles West of Sunflower	
Telephone No.	/ <u></u> /		
· · · · · · · · · · · · · · · · · · ·	Well Data		
		Tivot	
Purpose of Well (circle one) Home Ind	ustrial Public Supply Irrigati	ion Fish Culture Other Replacement	NJ
-			217
Date well drilling started:	$\mathcal{I} \mathcal{I} \mathcal{I}$ Date well drill	ng completed: $7^{-}/5^{-}0^{-}/600^{-}$	71
TCA			
If flowing, method of flow regulation: Val	ve Other (describe)		
If flowing, method of flow regulation: Val Static Water Level: 40 feet ab	ve Other (describe)		
Static Water Level: 40 feet ab	ove ontelow (circle one) land surf	ace Date measured: 4-19-07	
Static Water Level: 40 feet ab	ove ontelow (circle one) land surf		
Method of Measurement (circle one)	ove oncelow (circle one) land surf	ace Date measured: 4-19-07	
Static Water Level: <u>40</u> feet ab Method of Measurement (circle one) Hole depth: <u>135</u> Well dep	ove ontelow (circle one) land surf $\frac{1}{2}$ electric tape air $\frac{1}{3}$ Well	ace Date measured: <u>4-19-07</u> line other:	
Static Water Level: <u>40</u> feet ab Method of Measurement (circle one) Hole depth: <u>135</u> Well dep Type of grout (circle one); Cement	ove ontelow (circle one) land surf the 135 Well Bentonite Mix	ace Date measured: $4-19-07$ line other: grouted to a depth of feet	
Static Water Level: <u>40</u> feet ab Method of Measurement (circle one) Hole depth: <u>135</u> Well dep Type of grout (circle one); Cement	ove ontelow (circle one) land surf the 135 Well Bentonite Mix	ace Date measured: <u>4-19-07</u> line other:	
Static Water Level: $\frac{400}{100}$ feet ab Method of Measurement (circle one) $\frac{400}{100}$ Hole depth: $\frac{130}{100}$ Well dep Type of grout (circle one): Cement Casing length: $\frac{95}{400}$ feet Casin	ove ontelow (circle one) land surf the 135 well Bentonite Mix ng diameter: 14 inches	ace Date measured: $4-19-07$ line other: grouted to a depth of feet Type of casing: $\underline{PVC} = \underline{Sch} = 40$	_
Static Water Level: $\frac{400}{100}$ feet ab Method of Measurement (circle one) $\frac{400}{100}$ Hole depth: $\frac{130}{100}$ Well dep Type of grout (circle one): Cement Casing length: $\frac{95}{400}$ feet Casin	ove ontelow (circle one) land surf the 135 Well Bentonite Mix	ace Date measured: $\frac{4-19-07}{10}$ line other: grouted to a depth of feet Type of casing: $\frac{PVC}{PVC} \frac{5ch}{40} \frac{40}{10}$	-
Static Water Level:	ove ontelow (circle one) land surfice the 135 electric tape air the 135 Well Bentonite Mix ng diameter: 16 inches en diameter: 6	ace Date measured: $\frac{4-19-07}{10}$ line other: grouted to a depth of $\underline{10}$ feet Type of casing: \underline{PVC} <u>sch</u> 40 s Type of screen: \underline{PVC} <u>sch</u> 40	-
Static Water Level: $\frac{4}{100}$ feet ab Method of Measurement (circle one) $\frac{4}{100}$ Hole depth: $\frac{135}{100}$ Well dep Type of grout (circle one): Cement Casing length: $\frac{95}{100}$ feet Casin	ove ontelow (circle one) land surf the 135 well Bentonite Mix ng diameter: 14 inches	ace Date measured: $4-19-07$ line other: grouted to a depth of feet Type of casing: $\underline{PVC} = \underline{Sch} = 40$	-
Static Water Level:	ove on telow (circle one) land surf the	ace Date measured: $\frac{4-19-07}{10}$ line other: grouted to a depth of $\underline{10}$ feet Type of casing: \underline{PVC} <u>sch</u> 40 s Type of screen: \underline{PVC} <u>sch</u> 40	ent
Static Water Level: <u>40</u> feet ab Method of Measurement (circle one) 4 Hole depth: <u>135</u> Well dep Type of grout (circle one); Cement Casing length: <u>95</u> feet Casin Screen length: <u>1050</u> inches	ove ontelow (circle one) land surf the	ace Date measured: $\frac{4-19-07}{10}$ line other: grouted to a depth of $\underline{10}$ feet Type of casing: \underline{PVC} <u>sch</u> 40 s Type of screen: \underline{PVC} <u>sch</u> 40 2 feet to $\underline{35}$ feet	ent
Static Water Level:	ove on color (circle one) land surfice tape electric tape air th: Well Bentonite Mix ng diameter: inches en diameter: inches Setting depth: From Gravel packed Underreamed Other (describe):	ace Date measured: $\frac{4-19-07}{10}$ line other: grouted to a depth of feet Type of casing: $\frac{PVC}{SCL} \frac{SCL}{40}$ s Type of screen: $\frac{PVC}{SCL} \frac{SCL}{40}$ feet to feet Telescoped Open hole Natural Development	
Static Water Level:	ove on color (circle one) land surfice tape electric tape air th: Well Bentonite Mix ng diameter: inches en diameter: inches Setting depth: From Gravel packed Underreamed Other (describe):	ace Date measured: $\frac{4-19-07}{10}$ line other: grouted to a depth of $\underline{10}$ feet Type of casing: \underline{PVC} <u>sch</u> 40 s Type of screen: \underline{PVC} <u>sch</u> 40 2 feet to $\underline{35}$ feet	
Static Water Level: <u>40</u> feet ab Method of Measurement (circle one) 4 Hole depth: <u>135</u> Well dep Type of grout (circle one); Cement Casing length: <u>95</u> feet Casin Screen length: <u>1050</u> inches	ove ontelow (circle one) land surfice tape electric tape air th: Well Bentonite Mix g diameter: Mix inches en diameter: inches en diameter: inches Setting depth: From feet. If telescoped	ace Date measured: $4-19-07$ line other: grouted to a depth of feet Type of casing: $\underline{PVC} \underline{Sch} 40$ s Type of screen: $\underline{PVC} \underline{Sch} 40$ feet to feet Telescoped Open hole Natural Development or more than one screen, describe on back of particular location of the screen o	
Static Water Level:	ove ontelow (circle one) land surfice tape electric tape air th: Well Bentonite Mix g diameter: Mix inches en diameter: inches en diameter: inches Setting depth: From feet. If telescoped	ace Date measured: $4-19-07$ line other: grouted to a depth of feet Type of casing: $\underline{PVC} \underline{Sch} 40$ s Type of screen: $\underline{PVC} \underline{Sch} 40$ feet to feet Telescoped Open hole Natural Development or more than one screen, describe on back of particular location of the screen o	
Static Water Level:	ove ontelow (circle one) land surfice tape electric tape air th: Well Bentonite Mix g diameter: inches en diameter:	ace Date measured: $4-19-07$ line other: grouted to a depth of feet Type of casing: $PVC \ Sch \ 40$ S Type of screen: $PVC \ Sch \ 40$ 2 feet to feet Telescoped Open hole Natural Development or more than one screen, describe on back of party by Sonic Neutron Other:	age
Static Water Level:	ove on color (circle one) land surfice tape electric tape air th:	ace Date measured: $4-19-07$ line other: grouted to a depth of feet Type of casing: $PVC \ Sch \ 40$ S Type of screen: $PVC \ Sch \ 40$ 2 feet to feet Telescoped Open hole Natural Development I or more than one screen, describe on back of party Sonic Neutron Other:	age
Static Water Level:	ove ontelow (circle one) land surfice the set of the se	ace Date measured: $4-19-07$ line other: grouted to a depth of feet Type of casing: $PVC \ Sch \ 40$ S Type of screen: $PVC \ Sch \ 40$ 2 feet to feet Telescoped Open hole Natural Development I or more than one screen, describe on back of party Sonic Neutron Other:	age
Static Water Level:	ove on telow (circle one) land surfice the lectric tape air with diameter:	ace Date measured: $4-19-07$ line other: grouted to a depth of feet Type of casing: $PVC \ Sch \ 40$ S Type of screen: $PVC \ Sch \ 40$ 2 feet to feet Telescoped Open hole Natural Development I or more than one screen, describe on back of party Sonic Neutron Other:	age
Static Water Level:	ove ontelow (circle one) land surfice the lectric tape air well Bentonite Mix Bentonite Mix Mix ag diameter: inches en diameter:	ace Date measured: $4-19-07$ line other: grouted to a depth of feet Type of casing: $PVC \ Sch \ 40$ S Type of screen: $PVC \ Sch \ 40$ 2 feet to feet Telescoped Open hole Natural Development I or more than one screen, describe on back of party Sonic Neutron Other:	age

.

RECEIVED MAY 1 0 2007 BY: OLWE If well telescopes please sketch below and show depths.


Ground Level

• `

Description of Formations Encountered	From	То
	10	201
E'AR SAAD	21	35
Fine sand + gravel Fine sand + gravel medium sand + gravel	36	50
med: um sand + cravel	51	135
<u> </u>		
		4
		ļ
		<u> </u>
		_
		
	_	{
	_	
		╂──┨
		╂──┨
		╂╌╌┨
		+

4-

If more than one screen, show location of each on sketch

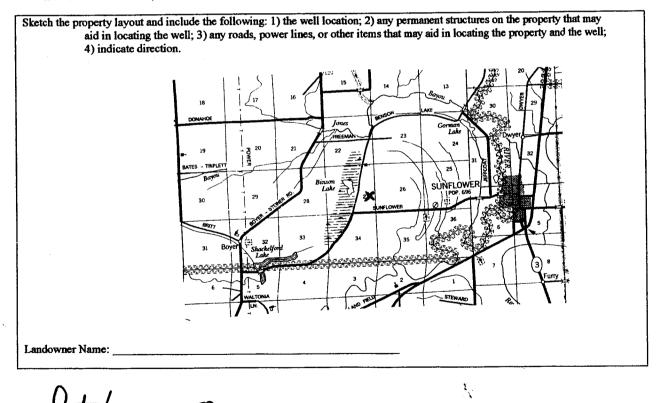

Signature of Water Well Contractor

SIATE WELL REPORT				
$\begin{array}{c} \text{County:} 2 \text{ Until 100000} \\ \text{Permit #:} \\ \hline \text{OUU 41757} \\ \text{Trris9tion Equipment} \\ \hline \text{Driker:} \\ \hline \text{Date completed:} \\ \hline \begin{array}{c} 4 - 13 - 07 \end{array} \end{array} \begin{array}{c} \text{Pump Installer} \\ \text{Mississippi Department} \\ \text{Office of Land} \\ \text{P.O.} \\ \text{Jackson,} \\ \text{(601)} \\ \text{(601)3} \end{array}$	Part 2 For Office Use Only: P's Completion Report Aquifer: ent of Environmental Quality Aquifer: and Water Resources Well #: Box 10631 Well #: MS 39289-0631 Elevation:			
This report should be prepared by the pump installer in detail and filed with the Department within 30 days of the installation of pump.				
Well Owner Information	Well Location			
Owner Name: P. HS Forms	Latitude:Longitude:			
Mailing Address: BOX 925	Method of Lat/Long (circle one): Conventional Survey,			
The iano la MS 38151 City State Zip Code Telephone No.	USGS quad, Hand-held GPS, Survey-grade GPS <u>4</u> <u>4</u> Sec <u>27</u> Twn <u>20</u> Rng <u>4</u> Distance Direction Nearest Town <u>3</u> Miles <u>West of Sunflower</u>			
Pum p Type				
Circle one	Power Type			
	Circle one			
Air Lift Jet Submersible	Dicsel Engine Gasoline Engine Natural Gas			
Bucket Piston Turbine	Electric Motor Hand Tractor PTO			
Centrifugal Rotary Flowing Well	Windmill Other (specify):			
Other (specify):	Horse Power Rating of Motor: 50			
Date Pump Installed: 4-19-07	Setting Depth: 70 feet			
Rated Pump Capacity:Gallons Per Minute	Number of Stages:			
Demo Trach D				
Pump Test Data Date Well Tested:	Method of Measuring Water Level Circle one			
Static Water Level (A):Feet Below Land Surface	Air Line Electric Measuring Line Steel Tape			
Pumping Water Level (B):Feet Below Land Surface	Other (specify):			
Drawdown [(B)-(A)]:Feet Below Land Surface	For flowing well, measured shut in head:feet			
Test Pumping Rate:Gallons Per Minute	Well yielded GPM with a drawdown of			
Duration of Pump Test (minimum 4 hours):hours	feet afterhours of pumping			
I HEREBY CERTIFY that the above statements are true to the best of <u>Patrick M. Chism 0695</u> <u>Print Name of Pump Installer and License No. (if applicable)</u>	my knowledge. RECEIVED Signature of Pump Installer MAY + C 107			
	BY: OLWF			

STATE WELL REPORT

· · · · ·