

42354

# State Well Report Part 1

County: Sunflower  
 Permit #: 42354  
 Driller: Irrigation Equipment  
 Date drilling completed: 2-29-08

Mississippi Department of Environmental Quality  
 Office of Land and Water Resources  
 P.O. Box 10631  
 Jackson, MS 39289-0631  
 (601)961-5210  
 (601)354-6938 (fax)

For Office Use Only:  
 Aquifer: \_\_\_\_\_  
 Well #: K-128  
 L. S. Elevation: \_\_\_\_\_  
 E-log #: \_\_\_\_\_

State Law requires that this report be prepared by the driller in detail and filed with the Department within 30 days of completion of drilling of the well.

Well Owner Information	Well Location
Owner Name: <u>Kirk and Company</u>	Latitude: <u>33° 36' 06.6"</u> Longitude: <u>90° 36' 52.9"</u>
Mailing Address: <u>32 Bobby Kirk Road</u>	Method of Lat/Long (circle one): <u>Conventional Survey</u>
<u>Doddsville Ms. 38736</u>	USGS quad, Hand-held GPS, Survey-grade GPS
City State Zip Code	<u>NE 1/4 NW 1/4 Sec 9 Twn 20N Rng 4W</u>
Telephone No. <u>662) 887-2512</u>	Distance Direction Nearest Town
	<u>1 Miles SE of Steiner</u>

**Well Data**

Purpose of Well (circle one) Home Industrial Public Supply Irrigation Fish Culture Other: \_\_\_\_\_

Date well drilling started: 2-29-08 Date well drilling completed: 2-29-08

If flowing, method of flow regulation: Valve \_\_\_\_\_ Other (describe) \_\_\_\_\_

Static Water Level: 48 feet above of below (circle one) land surface Date measured: 2-29-08

Method of Measurement (circle one) steel tape electric tape air line other: \_\_\_\_\_

Hole depth: 127 Well depth: 127 Well grouted to a depth of 10

Type of grout (circle one): Cement Bentonite Mix

Casing length: 87 feet Casing diameter: 16 inches Type of casing: PVC

Screen length: 40 feet Screen diameter: 16 inches Type of screen: PVC

Screen slot size: .050 inches Setting depth: From 88 feet to 127 feet

Type of completion (circle all applicable): Gravel packed Underreamed Telescoped Open hole Natural Development

Other (describe): \_\_\_\_\_

Top of lap pipe or reduction in casing: \_\_\_\_\_ feet. If telescoped or more than one screen, describe on back of page

Logs run (circle all applicable): No log run Electric Gamma Ray Density Sonic Neutron Other: \_\_\_\_\_

Name of organization running log(s): \_\_\_\_\_

RECEIVED  
 MAR 05 2008  
 BY: OLWR

I certify that the well was drilled, constructed, and completed in accordance with all applicable requirements of the Mississippi Department of Environmental Quality and/or the Mississippi Department of Health regulations and state laws.

Irrigation Equipment Inc.  
Patrick M. Chism 0695

Print Name of Water Well Contractor and License No. \_\_\_\_\_ Signature of Water Well Contractor \_\_\_\_\_

42354  
 6W42532

K-128

If well telescopes please sketch below and show depths.

Ground Level

Description of Formations Encountered	From	To
Clay	0	21
Fine Sand	22	27
Fine Sand + Gravel	28	49
Medium Sand + Gravel	50	127

If more than one screen, show location of each on sketch

Sketch the property layout and include the following: 1) the well location; 2) any permanent structures on the property that may aid in locating the well; 3) any roads, power lines, or other items that may aid in locating the property and the well; 4) indicate direction.

RECEIVED  
 MAR 05 2008  
 BY OLWR

Landowner Name: Kirk and Company

Signature of Water Well Contractor

42354

# STATE WELL REPORT

## Part 2

**Pump Installer's Completion Report**  
Mississippi Department of Environmental Quality  
Office of Land and Water Resources  
P.O. Box 10631  
Jackson, MS 39289-0631  
(601)961-5210  
(601)354-6938 (fax)

County: Sunflower  
 Permit #: 61042534  
 Driller: Irrigation Equipment  
 Date completed: 2-29-08

For Office Use Only:  
 Aquifer: \_\_\_\_\_  
 Well #: K-128  
 Elevation: \_\_\_\_\_

This report should be prepared by the pump installer in detail and filed with the Department within 30 days of the installation of pump.

Well Owner Information	Well Location
Owner Name: <u>Kirk and Company</u>	Latitude: _____ Longitude: _____
Mailing Address: <u>32 Bobby Kirk Road</u>	Method of Lat/Long (circle one): Conventional Survey, USGS quad, Hand-held GPS, Survey-grade GPS
<u>Doddsville Ms. 38736</u>	<u>NE 1/4 NW 1/4 Sec 9 Twn 20N Rng 4W</u>
City State Zip Code	Distance Direction Nearest Town
Telephone No. <u>(662) 887-2512</u>	<u>1 Miles SE of Steiner</u>

Pump Type Circle one	Power Type Circle one
Air Lift Jet Submersible	Diesel Engine Gasoline Engine Natural Gas
Bucket Piston <u>Turbine</u>	<u>Electric Motor</u> Hand Tractor PTO
Centrifugal Rotary Flowing Well	Windmill Other (specify): _____
Other (specify): _____	Horse Power Rating of Motor: <u>40</u>
Date Pump Installed: <u>2-29-08</u>	Setting Depth: <u>70</u>
Rated Pump Capacity: <u>1800±</u> Gallons Per Minute	Number of Stages: <u>2</u>

RECEIVED  
MAR 05 2008



Pump Test Data	Method of Measuring Water Level Circle one
Date Well Tested: _____	Air Line Electric Measuring Line Steel Tape
Static Water Level (A): _____ Feet Below Land Surface	Other (specify): _____
Pumping Water Level (B): _____ Feet Below Land Surface	For flowing well, measured shut in head: _____ feet
Drawdown [(B) - (A)]: _____ Feet Below Land Surface	Well yielded _____ GPM with a drawdown of _____ feet after _____ hours of pumping
Test Pumping Rate: _____ Gallons Per Minute	
Duration of Pump Test (minimum 4 hours): _____ hours	

BY OLWR

I HEREBY CERTIFY that the above statements are true to the best of my knowledge.


Patrick M. Chism 0695  
 Print Name of Pump Installer and License No. (if applicable)

[Signature]  
 Signature of Pump Installer

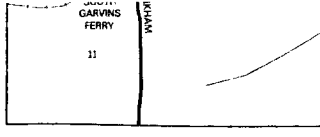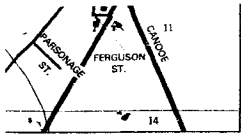

**Inset A**  
T 24 N R 3 W

**Inset B**  
T 18 N R 4 W

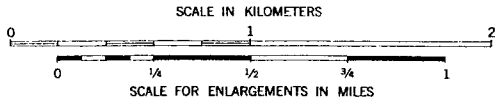

42354

*Kirk and Company*  
*Map*

BOLIVAR COUNTY

T 21 N

R 5 W

BOLIVAR COUNTY

**RECEIVED**  
**MAR 05 2008**  
**BY OLWR**

SHAW  
POP. 2,310  
IN BOLIVAR COUNTY  
POP. 2,341  
IN SUNFLOWER COUNTY  
POP. 0

T 20 N

BOLIVAR COUNTY

T 19 N

WASHINGTON COUNTY

Holly Ridge

To Leland

