

County: Sunflower
 Permit #: GW 44426
 Irrigation Equipment
 Driller:
 Date drilling completed: 6-17-10

State Well Report
Part 1 - Driller's Log
 Mississippi Department of Environmental Quality
 Office of Land and Water Resources
 P.O. Box 2309
 Jackson, MS 39225
 (601)961- 5210
 (601)961- 5228 (fax)

For Office Use Only:
 Aquifer: K 138
 Well #: _____
 L. S. Elevation: _____
 E-log #: _____

State Law requires that this report be prepared by the license holder responsible for the work and filed with the Department at the above address within 30 days of completion of drilling of the well or borehole.

Information on Well Owner (Landowner if borehole is not for a water well)	Well or Borehole Location
Owner Name: <u>Hard Cash Planting</u>	Latitude: <u>33.35.37.5</u> Longitude: <u>90.36.16.3</u>
Mailing Address: <u>P.O. Box 599</u>	Method of Lat/Long (circle one): Conventional Survey, USGS quad, Hand-held GPS, Survey-grade GPS <input checked="" type="checkbox"/>
<u>Indianola Ms. 38751</u> City State Zip Code	<u>NW 1/4 SW 1/4 Sec. 10 Twn 20N Rng 4W</u>
Telephone No. <u>662-887-6153</u>	Distance Direction Nearest Town <u>5</u> Miles <u>NW</u> of <u>Sunflower</u>

Well / Borehole Data

Date drilling started: 6-17-10 Date drilling completed: 6-17-10 Hole depth: 127 Hole diameter: 20"

Location of the source of any surface water used for drilling: Surface Water

Method of dosing and volume of Chlorine used in drilling and development: 50 PPM

Logs run (circle all applicable): No log run Electric Gamma Ray Density Sonic Neutron Other: _____

Name of organization running log(s): _____

Purpose of borehole (check one): Water Well Geotechnical/Geological Investigation Ground Source Heat Pump
 Seismic Survey Other (describe) _____

If drilling is not related to water well construction, skip the remainder of this block

Purpose of Well (check one): Home Industrial Public Supply Irrigation Fish Culture Other: Replacement

If a flowing well, method of flow regulation: Valve _____ Other (describe) _____

Static Water Level: 48' feet above below (circle one) land surface Date measured: 6-17-2010

Method of Measurement (circle one) steel tape electric tape air line other: _____

Well depth: 127 Well grouted to a depth of 10 feet Type of grout (circle one): Neat Cement Bentonite Mix

Casing length: 87 feet Casing diameter: 12 inches Type of casing: PVC

Screen length: 40 feet Screen diameter: 12 inches Type of screen: PVC

Screen slot size: .050 inches Setting depth: From 88 feet to 127 feet

Type of completion (circle all applicable): Gravel packed Underreamed Telescoped Open hole Natural Development
 Other (describe): _____

Top of lap pipe or reduction in casing: _____ feet. *If telescoped or more than one screen, describe on next page*

Form: OLWR-SWR-1A (04/08)


RECEIVED
 JUL 22 2010
 BY: OLWR

K138

The sketch below only required for water wells

Description of formations encountered must be provided for all wells and boreholes, unless specifically exempted by regulations

If well telescopes, show depths on sketch

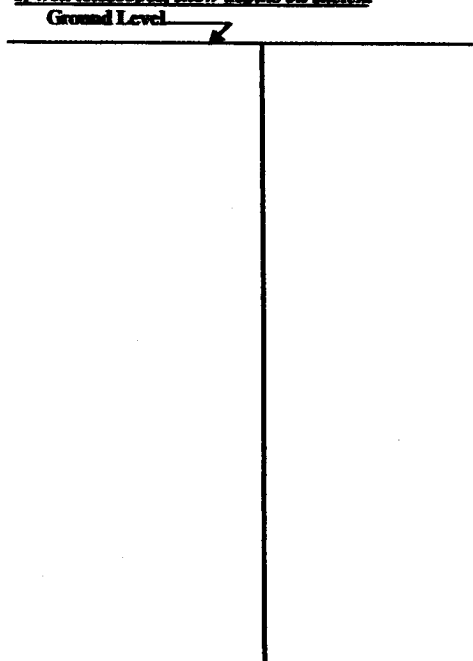

Description of Formations Encountered	From (depth)	To (depth)
Clay	Ground Level	21
Fine Sand	22	38
Fine Sand + Gravel	39	55
Medium Sand + Gravel	56	124
Clay	125	127

If more than one screen, show location of each on sketch

Sketch the property layout and include the following: 1) the well location; 2) any permanent structures on the property that may aid in locating the well; 3) any roads, power lines, or other items that may aid in locating the property and the well; 4) a north arrow.

Landowner Name: Hard Cash

Form: OLWR-SWR-1A (04/08)

I certify that the well/borehole was drilled, constructed, and completed in accordance with all applicable requirements of the Mississippi Department of Environmental Quality and the Mississippi Department of Health regulations, if applicable, and state laws.

Patrick M Chism 0695

[Signature]

Print Name of Responsible Licensee and License No. Date

Signature of Licensee

RECEIVED
JUL 22 2010
BY: OLWR

STATE WELL REPORT

Part 2

Pump Installer's Completion Report
 Mississippi Department of Environmental Quality
 Office of Land and Water Resources
 P.O. Box 2309
 Jackson, MS 39225
 (601)961-5210
 (601)961-5228 (fax)

County: Sunflower
 Permit #: GW 44426
 Irrigation Equipment
 Driller: _____
 Date completed: 6-17-10
 Copy information from back on Part 1

For Office Use Only:
 Aquifer: K138
 Well #: _____
 Elevation: _____

This part of the report must be completed by a licensed water well contractor or a licensed pump installer. A copy of Part 1 of the report must be attached and both parts filed with the Department at the above address within 30 days of well completion.

Well Owner Information	Well Location
Owner Name: <u>Hard Cash Planting</u>	Latitude: _____ Longitude: _____
Mailing Address: <u>P.O. Box 599</u>	Method of Lat/Long (check one): Conventional Survey _____
<u>Indianola Ms. 38751</u>	USGS quad _____, Hand-held GPS <input checked="" type="checkbox"/> , Survey-grade GPS _____
City State Zip Code	<u>NW 1/4 SW 1/4 Sec 10 T20N R 4W</u>
Telephone No. () _____	Distance Direction Nearest Town <u>5</u> Miles <u>NW</u> of <u>Sunflower</u>

Pump Type	Power Type
Air Lift	Circle one
Jet	Submersible <input checked="" type="checkbox"/>
Bucket	Diesel Engine Gasoline Engine Natural Gas
Centrifugal	<input checked="" type="checkbox"/> Electric Motor Hand Tractor PTO
Rotary	Windmill Other (specify): _____
Flowing Well	Horse Power Rating of Motor: <u>40</u>
Other (specify): _____	Setting Depth: <u>70</u> feet
Date Pump Installed: <u>6-17-2010</u>	Number of Stages: <u>1</u>
Rated Pump Capacity: <u>1600</u> Gallons Per Minute	

Pump Test Data	Method of Measuring Water Level
Date Well Tested: _____	Circle one
Static Water Level (A): _____ Feet Below Land Surface	Air Line Electric Measuring Line Steel Tape
Pumping Water Level (B): _____ Feet Below Land Surface	Other (specify): _____
Drawdown [(B) - (A)]: _____ Feet Below Land Surface	For flowing well, measured shut in head: _____ feet
Test Pumping Rate: _____ Gallons Per Minute	Well yielded _____ GPM with a drawdown of _____ feet after _____ hours of pumping
Duration of Pump Test (minimum 4 hours): _____ hours	

This is for (circle one): New Well Replacement of Existing Pump Repair of Existing Pump

I HEREBY CERTIFY that the above statements are true to the best of my knowledge.
 Patrick M Chism 0695 Patrick M Chism
 Print Name of Pump Installer and License No. (if applicable) Signature of Pump Installer

Form: OLWR-SWR-1C (07-09)

RECEIVED
 JUL 22 2010
 BY: OLWR