County: Sunflower	STATE WELL R	ерокі	For Office Use Only:
······································	Part 1		Well#: K158
Permit #: <u>GW-46796 /</u>	Driller's Log Mississippi Department of Envir		Aquifer:
Driller: Irrigation Equipment	Office of Land and Water	Resources	E-Log #:
Date drilling completed: 08/19/2013	P.O. Box 2309 Jackson, MS 39225		
	(601) 961-5210)	
	(601) 360-0535 (f		
State Law requires that this report	be prepared by the license hold	er responsible for	the work and filed with the
Department at the above address w Well Owner informa			rehole Location
(Landowner if borehole is not fo	or a water well)		
Owner Name: Parker Brothers	Latitude:	33 32' 09.8 N	Longitude: 90 35' 21.0 W
Mailing Address: P.O. Box 277	Method of	Lat/Long (check on	e): 🔲 Conventional Survey,
		-	IGPS, 🗍 Survey-grade GPS
Sunflower Ms	38778 e Zip code	<u>se</u> % <u>ne</u> %, s	ec <u>34</u> T <u>20 N</u> R <u>4 W</u>
Telephone No. () -	3	Miles Wes	t of Sunflower
······	(Distan		
	Well / Borehole Data		
Location of the source of any surface wat Method of dosing and volume of Chlorine	U	50 PPM	
Logs run (check all applicable): 🛛 No log	ı run 🔲 Electric 🗌 Gamma Ray 🔲	Density 🔲 Sonic 🗌	Neutron 🗌 Other:
Name of organization running log(s):			
Purpose of borehole (check one): \square	ater Well 🔲 Geotechnical/Geolo		Ground Source Heat Pump
· · · · · · · · · · · · · · · · · · ·		g	
		riha)	
	eismic Survey Other (desc		
	tersmic Survey D Other (desc ated to water well construction,		er of this block
If drilling is not rela	ated to water well construction,	skip the remaind	
<i>If drilling is not rela</i> Purpose of Well (check all applicable):	ated to water well construction,	skip the remaind	
<i>If drilling is not rel</i>	nted to water well construction, Home I Industrial I Public Supply	skip the remaind	h Culture
If drilling is not related and the second se	ated to water well construction, Home [] Industrial [] Public Supply n: Valve Other (defined to the set []] above or [] below] land surface	skip the remaind / ⊠ Irrigation □ Fis escribe)	h Culture
<i>If drilling is not rela</i> Purpose of Well (<i>check all applicable</i>): Other (<i>describe</i>): f a flowing well, method of flow regulation Static Water Level: <u>46'</u>	ated to water well construction, Home [] Industrial [] Public Supply n: Valve Other (defined to the set [] above or [] below] land surfact (check one)	skip the remaind Irrigation [] Fis escribe) ace Date meas	h Culture sured:
<i>If drilling is not rela</i> Purpose of Well (<i>check all applicable</i>): Other (<i>describe</i>): f a flowing well, method of flow regulation Static Water Level: 46' Method of Measurement (check one)	ated to water well construction, Home [] Industrial [] Public Supply n: Valve Other (defined to the set []] above or [] below] land surfact (check one) Steel tape [] Electric tape [] Air line	skip the remaind y 🖾 Irrigation 🗆 Fis escribe) ace Date meas e 🗋 Other: (describe)	h Culture sured: 08/19/2013
If drilling is not related Purpose of Well (check all applicable): Other (describe): Other (describe): f a flowing well, method of flow regulation Static Water Level: 46' Method of Measurement (check one) 5 Well depth: 116 Well grouted to a base	ated to water well construction, Home [] Industrial [] Public Supply h: Valve Other (degreet []] above or [] below] land surfact (check one) Steel tape [] Electric tape [] Air line depth of: _10 feet Type of get	skip the remaind skip the remaind y [2] Irrigation [] Fis escribe) escribe) ace Date meas e [] Other: (describe rout (check one): []	h Culture sured: <u>08/19/2013</u>
If drilling is not relation Purpose of Well (check all applicable): Other (describe): Other (describe): f a flowing well, method of flow regulation Static Water Level: 46' Method of Measurement (check one) 5 Well depth: 116 Well grouted to a black one Casing length: 76 feet	ated to water well construction, Home [] Industrial [] Public Supply h: Valve Other (defined in the set []) above or [] below] land surfact (check one) Steel tape [] Electric tape [] Air line depth of: 10 feet Type of gr Casing diameter: 16	skip the remaind y [2] Irrigation [] Fis escribe) escribe) ace Date meas e [] Other: (describe rout (check one): [] _ inches Type of	h Culture sured:
If drilling is not relation Purpose of Well (check all applicable): Other (describe): Other (describe): f a flowing well, method of flow regulation Static Water Level: 46' Method of Measurement (check one) 5 Well depth: 116 Well grouted to a flow Casing length: 76 feet Screen length: 40 feet	ated to water well construction, Home [] Industrial [] Public Supply h: Valve Other (defined in the set []) above or [] below] land surfaction (check one) Steel tape [] Electric tape [] Air line depth of: 10 feet Type of gr Casing diameter: 16 Screen diameter: 16	skip the remaind skip the remaind y [2] Irrigation [] Fis escribe) escribe) ace Date meas e [] Other: (describe rout (check one): [] _ inches Type of _ inches Type of	h Culture sured:
If drilling is not relation Purpose of Well (check all applicable): Other (describe): Other (describe): f a flowing well, method of flow regulation Static Water Level: 46' Method of Measurement (check one) 5 Well depth: 116 Well grouted to a Casing length: 76 feet Screen length: 40 feet Screen slot size: _050 jr	ated to water well construction, Home [] Industrial [] Public Supply h: Valve Other (decent is the set []] above or [] below] land surfactories (check one) Steel tape [] Electric tape [] Air line depth of: 10 feet Type of get Casing diameter: 16 Screen diameter: 16 aches Setting depth: From 7	skip the remaind skip the remaind y [2] Irrigation [] Fis escribe) escribe) ace Date meas e [] Other: (describe rout (check one): [] _ inches Type of _ inches Type of _ inches Type of _ inches Type of	h Culture sured: 08/19/2013 e) Neat Cement ⊠ Bentonite □ Mi casing: PVC screen: PVC et to 116feet
If drilling is not relation Purpose of Well (check all applicable): Other (describe): Other (describe): f a flowing well, method of flow regulation Static Water Level: 46' Method of Measurement (check one) 5 Well depth: 116 Well grouted to a Casing length: 76 feet Screen length: 40 feet Screen slot size: .050 ir 'ype of completion (check all applicable): 1	ated to water well construction, Home [] Industrial [] Public Supply h: Valve Other (decent is the set []] above or [] below] land surfactories (check one) Steel tape [] Electric tape [] Air line depth of: 10 feet Type of get Casing diameter: 16 Screen diameter: 16 aches Setting depth: From 7	skip the remaind skip the remaind y [2] Irrigation [] Fis escribe) escribe) ace Date meas e [] Other: (describe rout (check one): [] _ inches Type of _ inches Type of _ inches Type of _ inches Type of	h Culture sured: 08/19/2013 e) Neat Cement ⊠ Bentonite □ Mi casing: PVC screen: PVC et to 116feet
If drilling is not relation Purpose of Well (check all applicable): Other (describe): 1 Other (describe): if a flowing well, method of flow regulation Static Water Level: 46' Method of Measurement (check one) 3 Well depth: 116 Well grouted to a flow Casing length: 76 feet Screen length: 40 feet	ated to water well construction, Home [] Industrial [] Public Supply h: Valve Other (decent is the set []] above or [] below] land surfactories (check one) Steel tape [] Electric tape [] Air line depth of: 10 feet Type of get Casing diameter: 16 Screen diameter: 16 aches Setting depth: From 7	skip the remaind skip the remaind y [2] Irrigation [] Fis escribe) escribe) ace Date meas e [] Other: (describe rout (check one): [] _ inches Type of _ inches Type of _ inches Type of _ inches Type of	h Culture sured: 08/19/2013 e) Neat Cement ⊠ Bentonite □ Mi casing: PTTE ○ ○ ○ ○ ○ ○ ○ screen: PVC et to 116feet

Ļ

٦

Form: OLWR-SWR-1A (4/13)

	For Office Use Only:
Weli#:	K158


BY: OLWP

The sketch below only required for water wells

If well telescopes, show depths on sketch.

County: Sunflower
Permit #: GW-46796

1

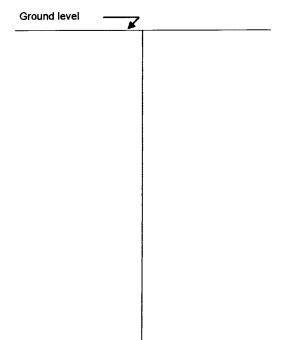

Description of formations encountered must be provided for all wells and boreholes, unless specifically exempted by regulations

Description of Formations Encountered	From (depth)	To (depth)
Clay	Ground level	20
Fine Sand	21	51
Fine Sand & Gravel	52	64
Medium Sand & Gravel	65	113
Clay	114	116
	1	
	1	
	+	
· · · · · · · · · · · · · · · · · · ·	1	
· · · · · · · · · · · · · · · · · · ·		
······································		

If more than one screen, show location of each on sketch

2) any permane	tion ent structures on the property that ma ower lines, or other items that may a	ay aid in locating the well id in locating the property a	and the well
4) a north arrow			
Landowner Name:	Parker Brothers		
			Form: OLWR-SWR-1A (04/08)
HEREBY CERTIFY	' that the well/borehole was drilled, c Mississippi Department of Environme	onstructed, and completed ental Quality and the Missis	
HEREBY CERTIFY requirements of the I f applicable, and sta Patrick Chism	' that the well/borehole was drilled, c Mississippi Department of Environme	onstructed, and completed ental Quality and the Mass 08/26/2013	in accordance with all applicable

	1	ELL REPORT	1	Office Use Only:
County: Sunflower		Part 2		K158
Permit #: GW-46796		's Completion Repor ent of Environmental Qual	ity	
Driller: Irrigation Equipment	Office of Land	and Water Resources). Box 2309		
Date drilling completed: 08/19/2013 Copy information from block on Part 1	Jackson	MS 39225-2309		
		1) 961-5210 360-0535 (fax)		
This part of the report must be completed	l hv a licensed water we	ll contractor or a licensed p	ump installer. A	copy of Part 1
of the report must be attached and both p	parts filed with the Depa	urtment at the above address	within <u>30 days</u> Well Location	of well completion.
Well Owner Informat	101			
Owner Name: Parker Brothers		Latitude: 33 32' 09.8 N	Longitud	e: 90 35' 21.0 W
ailing Address: P.O. Box 277		Method of Lat/Long (chec	k one): 🔲 Co	onventional Survey,
		USGS quad, 🛛 Hand	held GPS	Survey-grade GPS
Sunflower Ms City State	38778 Zip code	<u>SE</u> % <u>NE</u>	¼, Sec <u>34</u> ⊺ <u>20</u>	<u>n</u> R <u>4 W</u>
		3 Miles	West of	Sunflower
· · · · · · · · · · · · · · · · · · ·		(Distance) (D	Nirection)	(Nearest Town)
	Pump Typ	e (check one)		
🗌 Submersible 🛛 Turbine 🗌 Air Lift 🗌 C	entrifugal 🔲 Flowing W	/ell 🗋 Jet 🗋 Piston 🗋 Rota	ry 🗌 Other (des	scribe):
	r i	Rated Pump Capacity: 230	0+/-	Gallons Per Minute
	paired 🗌 Replacement			
ls This Pump <i>(check one)</i> : 🛛 New 🗌 Re	paired Replacement Power Typ	e (check one)		
ls This Pump <i>(check one)</i> : ⊠ New	paired [] Replacement Power Typ al Gas [] Tractor PTO	e (check one)	-	
s This Pump <i>(check one)</i> : 🛛 New 🗌 Rej 🛛 Electric 🗋 Diesel 🗋 Gasoline 🗋 Natur	paired [] Replacement Power Typ al Gas [] Tractor PTO	e (check one)	-	ages: 2
ls This Pump <i>(check one)</i> : ⊠ New	paired CREPIacement Power Typ al Gas CREAT Tractor PTO Setting Depth:	e (check one)	-	ages: 2
Is This Pump <i>(check one)</i> : New Reg	paired CREPIacement Power Typ al Gas CREAT Tractor PTO Setting Depth:	e (check one) Uvindmill D Other (descr. 80 feet	Number of Sta	
Is This Pump <i>(check one)</i> : New Reg	Paired Replacement Power Typ al Gas Tractor PTO Setting Depth: Pump Test Data for	e (check one) Windmill Other (descr. 80 feet or Non Flowing Well Duration of Pump Test (m	Number of Sta	:): Hours
Is This Pump <i>(check one)</i> : New Reg	Paired CREPIACEMENT Power Typ al Gas CREAT Tractor PTO Setting Depth: Pump Test Data for et Below Land Surface	e (check one) Windmill Dother (descr. 80 feet or Non Flowing Well Duration of Pump Test (m Pumping Water Level (B)	Number of Sta inimum 4 hours	;): Hours
Is This Pump (check one): I New I Rep Is This Pump (check one): I New I Rep Is Electric I Diesel I Gasoline I Natur Horse Power Rating of Motor: 60 Date Well Tested: Static Water Level (A): Fee Drawdown [(B) - (A)]:	Paired C Replacement Power Typ al Gas Tractor PTO Setting Depth: Pump Test Data for et Below Land Surface Feet Below Land Surfa	e (check one) Windmill D Other (descr. 80 feet or Non Flowing Well Duration of Pump Test (m Pumping Water Level (B) ce Test Pumping Rate: _	Number of Sta inimum 4 hours	;): Hours
Is This Pump (check one): New Rep Electric Diesel Gasoline Natur Horse Power Rating of Motor: 60 Date Well Tested: Static Water Level (A): Fee Drawdown [(B) - (A)]:	Paired C Replacement Power Typ al Gas Tractor PTO Setting Depth: Pump Test Data for et Below Land Surface Feet Below Land Surface Steel tape C Electric tap	e (check one) Windmill D Other (descr. 80 feet or Non Flowing Well Duration of Pump Test (m Pumping Water Level (B) ce Test Pumping Rate: _	Number of Sta inimum 4 hours	;): Hours
Is This Pump (check one): New [] Rep Is This Pump (check one): [] Solution Is Electric [] Diesel [] Gasoline [] Natur Horse Power Rating of Motor: 60 Date Well Tested: Static Water Level (A): Fee Drawdown [(B) - (A)]: Method of measurement (check one): [] S	Paired C Replacement Power Typ al Gas Tractor PTO Setting Depth: Pump Test Data for et Below Land Surface Feet Below Land Surface Steel tape C Electric tap	e (check one) UVindmill U Other (descr. 80 feet or Non Flowing Well Duration of Pump Test (m Pumping Water Level (B) ce Test Pumping Rate: _ pe U Air line U Other (descreen)	Number of Sta inimum 4 hours	;): Hours
Is This Pump (check one): I New I Report Is This Pump (check one): I New I Report Is Electric I Diesel I Gasoline I Natur Horse Power Rating of Motor: Date Well Tested: Static Water Level (A): Drawdown [(B) - (A)]: Method of measurement (check one): Statured shut in head:	Paired C Replacement Power Typ al Gas Tractor PTO Setting Depth: Pump Test Data for the Below Land Surface Feet Below Land Surface Steel tape Electric ta Pump Test Data Feet	e (check one) UVindmill U Other (descr. 80 feet or Non Flowing Well Duration of Pump Test (m Pumping Water Level (B) ce Test Pumping Rate: _ pe U Air line U Other (descreen)	Number of Sta inimum 4 hours : F cribe):	eet Below Land Surface Gallons Per Minute
Is This Pump (check one): I New I Report Is This Pump (check one): I Sector Is Electric I Diesel I Gasoline I Natur Horse Power Rating of Motor: Date Well Tested: Static Water Level (A): Drawdown [(B) - (A)]: Method of measurement (check one): Statured shut in head:	Paired C Replacement Power Typ al Gas Tractor PTO Setting Depth: Pump Test Data for et Below Land Surface Feet Below Land Surfa Steel tape Electric ta Pump Test Data Feet freet	e (check one) Windmill Other (descr. 80 feet or Non Flowing Well Duration of Pump Test (m Pumping Water Level (B) ce Test Pumping Rate: _ pe Air line Other (descr a for Flowing Well feet after	Number of Sta inimum 4 hours : F cribe):	eet Below Land Surface Gallons Per Minute
Is This Pump (check one): ⊠ New □ Reg ⊠ Electric □ Diesel □ Gasoline □ Natur Horse Power Rating of Motor: 60 Date Well Tested: Static Water Level (A): Fee Drawdown [(B) - (A)]: Method of measurement (check one): □ S Measured shut in head: Mell yielded GPM with a	Paired C Replacement Power Typ al Gas Tractor PTO Setting Depth: Pump Test Data for et Below Land Surface Feet Below Land Surface Steel tape Electric tap Pump Test Data Steel tape Meter In	e (check one) Windmill Other (descr. 80 feet or Non Flowing Well Duration of Pump Test (m Pumping Water Level (B) ce Test Pumping Rate: _ pe Air line Other (descr a for Flowing Well feet after	Number of Sta	;): Hours Feet Below Land Surface Gallons Per Minute
Is This Pump (check one): New □ Rep Is This Pump (check one): Is New □ Rep Is Electric □ Diesel □ Gasoline □ Natur Horse Power Rating of Motor: 60 Date Well Tested: Static Water Level (A): Fee Drawdown [(B) - (A)]: Method of measurement (check one): □ S Measured shut in head: Well yielded GPM with a Meter Manufacturer: None Installed	Paired CREPIACEMENT Power Typ al Gas Tractor PTO Setting Depth: Pump Test Data for et Below Land Surface Feet Below Land Surface Steel tape Electric tap Pump Test Data Feet drawdown of <u>Meter In</u>	e (check one) Windmill D Other (descr. 80 feet or Non Flowing Well Duration of Pump Test (m Pumping Water Level (B) ce Test Pumping Rate: _ pe Air line D Other (descr a for Flowing Well feet after feet after Meter Serial Number:	Number of Sta	Feet Below Land Surface Gallons Per Minute
Is This Pump (check one): New Rep Is This Pump (check one): New Rep Is Electric Diesel Gasoline Natur Horse Power Rating of Motor: 60 Date Well Tested: Date Well Tested: Static Water Level (A): Fee Drawdown [(B) - (A)]: Method of measurement (check one): S Measured shut in head: Melasured shut in head: Mell yielded GPM with a Meter Manufacturer: None Installed Meter Model Number/Name:	Paired CREPIACEMENT Power Typ al Gas Tractor PTO Setting Depth: Pump Test Data for et Below Land Surface Feet Below Land Surfa Steel tape Electric ta Pump Test Data Feet drawdown of Meter In	e (check one) Windmill Other (descr. 80 feet or Non Flowing Well Duration of Pump Test (m Pumping Water Level (B) ce Test Pumping Rate: pe Air line Other (descr a for Flowing Well feet after feet after stallation Meter Serial Number: Type of Meter:	Number of Sta	;): Hours Feet Below Land Surface Gallons Per Minute
Is This Pump (check one): ☑ New □ Reg Is This Pump (check one): ☑ New □ Reg Is Electric □ Diesel □ Gasoline □ Natur Horse Power Rating of Motor: 60 Date Well Tested: Static Water Level (A): Fee Drawdown [(B) - (A)]: Method of measurement (check one): □ S Method of mea	Paired C Replacement Power Typ al Gas Tractor PTO Setting Depth: Pump Test Data for et Below Land Surface Feet Below Land Surface Steel tape E Electric tap Pump Test Data Steel tape Meter In Meter In pr (AF x .001, gal x 1000	e (check one) Windmill D Other (descr. 80 feet or Non Flowing Well Duration of Pump Test (m Pumping Water Level (B) ce Test Pumping Rate: _ pe Air line D Other (descr a for Flowing Well feet after feet after stallation feet after: Type of Meter: 0, etc):	Number of Sta	Feet Below Land Surface Gallons Per Minute
Is This Pump (check one): ☑ New □ Reg ☑ Electric □ Diesel □ Gasoline □ Natur Horse Power Rating of Motor: 60 ① Date Well Tested: Static Water Level (A): □ Fee Drawdown [(B) - (A)]: Method of measurement (check one): ③ Measured shut in head: Well yielded GPM with a Meter Manufacturer: None Installed Meter Model Number/Name: Itotalizer Register Unit and Multiplier Factor nstallation Date:	Paired Replacement Power Typ al Gas Tractor PTO Setting Depth: Pump Test Data for et Below Land Surface Feet Below Land Surfa Steel tape Feet Grawdown of Meter In or (AF x .001, gal x 1000 Meter installed by:	e (check one) Windmill Other (descr. 80 feet or Non Flowing Well Duration of Pump Test (m Pumping Water Level (B) ce Test Pumping Rate: pe Air line Other (descr a for Flowing Well feet after feet after stallation Meter Serial Number: Type of Meter:	Number of Sta	Feet Below Land Surface Gallons Per Minute
Is This Pump (check one): New Is This Pump (check one): New Is Electric Diesel Gasoline Natur Horse Power Rating of Motor: 60 Date Well Tested:	Paired Replacement Power Typ al Gas Tractor PTO Setting Depth: Pump Test Data fe et Below Land Surface Feet Below Land Surfa Steel tape Electric tap Pump Test Data Feet drawdown of Meter In or (AF x .001, gal x 1000 Meter installed by: Paired Replacement	e (check one) Windmill D Other (descr. 80	Number of Sta	i): Hours Feet Below Land Surface Gallons Per Minute
Is This Pump (check one): ☑ New □ Reg ☑ Electric □ Diesel □ Gasoline □ Natur Horse Power Rating of Motor: 60 □ 60 □ □ □ □ □ 0 □ 0 <t< td=""><td>Paired Replacement Power Typ al Gas Tractor PTO Setting Depth: Pump Test Data fe et Below Land Surface Feet Below Land Surfa Steel tape Electric tap Pump Test Data Feet drawdown of Meter In or (AF x .001, gal x 1000 Meter installed by: paired Replacement Information you are certified</td><td>e (check one) Windmill D Other (descr. 80</td><td>Number of Sta inimum 4 hours : F cribe): f stalled to manu</td><td>i): Hours Feet Below Land Surface Gallons Per Minute</td></t<>	Paired Replacement Power Typ al Gas Tractor PTO Setting Depth: Pump Test Data fe et Below Land Surface Feet Below Land Surfa Steel tape Electric tap Pump Test Data Feet drawdown of Meter In or (AF x .001, gal x 1000 Meter installed by: paired Replacement Information you are certified	e (check one) Windmill D Other (descr. 80	Number of Sta inimum 4 hours : F cribe): f stalled to manu	i): Hours Feet Below Land Surface Gallons Per Minute
Is This Pump (check one): ☑ New □ Rep Is This Pump (check one): ☑ Soline □ Natur Is Electric □ Diesel □ Gasoline □ Natur Horse Power Rating of Motor: 60 Date Well Tested:	paired □ Replacement Power Typ al Gas □ Tractor PTO	e (check one) Windmill D Other (descr. 80 feet or Non Flowing Well Duration of Pump Test (m Pumping Water Level (B) ce Test Pumping Rate: pe D Air line D Other (descr a for Flowing Well feet after feet after astallation feet after: 0, etc): tifying that this meter was in oved meters is on the MDEQ	Number of Sta inimum 4 hours : F cribe): f stalled to manu	i): Hours Feet Below Land Surface Gallons Per Minute
Is This Pump (check one): ☑ New □ Reg Is Electric □ Diesel □ Gasoline □ Natur Horse Power Rating of Motor: 60 Date Well Tested:	paired □ Replacement Power Typ al Gas □ Tractor PTO	e (check one) Windmill D Other (descr. 80 feet or Non Flowing Well Duration of Pump Test (m Pumping Water Level (B) ce Test Pumping Rate: pe D Air line D Other (descr a for Flowing Well feet after feet after astallation feet after: 0, etc): tifying that this meter was in oved meters is on the MDEQ	Number of Sta inimum 4 hours : F cribe): f stalled to manu	i): Hours Feet Below Land Surface Gallons Per Minute
Is This Pump (check one): ☑ New □ Rep Is This Pump (check one): ☑ Soline □ Natur Is Electric □ Diesel □ Gasoline □ Natur Horse Power Rating of Motor: 60 Date Well Tested:	paired □ Replacement Power Typ al Gas □ Tractor PTO	e (check one) Windmill D Other (descr. 80 feet or Non Flowing Well Duration of Pump Test (m Pumping Water Level (B) ce Test Pumping Rate: pe D Air line D Other (descr a for Flowing Well feet after feet after astallation feet after: 0, etc): tifying that this meter was in oved meters is on the MDEQ	Number of Sta inimum 4 hours : F cribe): f stalled to manu	i): Hours Feet Below Land Surface Gallons Per Minute

, ,

BY: (JUMP