County: Sunflower	STATE W	VELL REPORT Part 1	For Office Use Only:
Permit #: GW-49561 Driller: Irrigation Equipment, Inc. Date drilling completed: 6-20-16	Part I Driller's Log Mississippi Department of Environmental Quality Office of Land and Water Resources P.O. Box 2309 Jackson, MS 39225-2309 (601) 961-5210 (601) 360-0535 (fax)		Aquifer:
State Law requires that this report of Department at the above address w Well Owner Informa (Landowner if borehole is not fo Owner Name: Edgar N. Donahoe, Jr.	<i>ithin 30 days of com</i> tion or a water well)	pletion of drilling of the we	Il or borehole. brehole Location
Mailing Address: 400 East Percy Stre		Method of Lat/Long (check or	ne): Donventional Survey,
Indianola MS City State	38751 e Zip code		d GPS,
Telephone No. () -	······································	Miles Nort (Distance) (Direct	
	run 🗌 Electric 🔲 Gan	-	
	eismic Survey	hnical/Geological Investigation Other (<i>describe</i>)	
Purpose of Well (check all applicable):	Home 🗆 Industrial 🗔 I LO GW -	07480	h Culture
Static Water Level: 47 fe			sured: <u>6-20-16</u>
Method of Measurement (check one)			
Well depth: 126' Well grouted to a c Casing length: 86 feet			reat Cement 🔯 Bentonite 📋 M
Screen length: <u>40</u> feet Screen slot size: <u>.050</u> in Type of completion (check all applicable):	•	From 87 30 Kec	et to 126 feet
Other (describe): Top of lap pipe or reduction in casing:	Feet	en y	n star
· · · · · · · · · · · ·		e screen, describe on next pag	e

Form: OLWR-SWR-1A (4/13)	

· .

	For Office Use Only: Well #:
<u>ells</u>	Description of formations encountered must be provided for all wells and boreholes, unless specifically exempted by regulations


Description of Formations Encountered

The sketch below only required for water we

If well telescopes, show depths on sketch.

County: Sunflower
Permit #: GW-49561

,

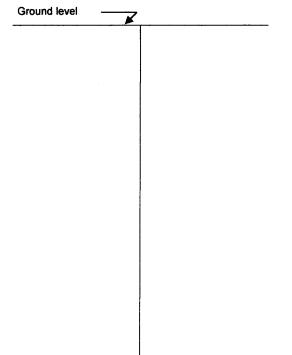

Clay	Ground level	19
Fine Sand	20	53
Fine Sand & Gravel	54	75
Med. Sand & Gravel	76	126
	1	
		[·····
<u></u>		
· · · · · · · · · · · · · · · · · · ·	+	<u> </u>
		<u> </u>
· · · · · · · · · · · · · · · · · · ·	<u> </u>	
·····		
<u></u>		
·····		
•••••••••••••••••••••••••••••••••••••••		
· · · · · · · · · · · · · · · · · · ·		
·····	l	
	<u> </u>	ļ

From (depth)

To (depth)

If more than one screen, show location of each on sketch

Sketch the property layout and include the following:

1) the well location

2) any permanent structures on the property that may aid in locating the well

3) any roads, power lines,			

4) a north arrow

		Received
		jun 2 9 2016
		By OLWR
Landowner Name:		
I HEREBY CERTIFY that the well/borehole was drilled, cor requirements of the Mississippi Department of Environment if applicable, and state laws.	tal Quality and the	Form: OLWR-SWR-1A (04/08) pleted in accordance with all applicable e Vississippi Department of Health regulations,
0695 Print Name of Responsible Licensee and License No.	6-24-16 Date	Signature of Licensee
		Form: OLWR-SWR-1A (4/13)

	STATE W	ELL REPORT	For Office Use Only:
County: Sunflower		Part 2	
Permit #: GW-49561	Pump Installer	s Completion Report	
Driller: Irrigation Equipment, Inc.		ent of Environmental Quality and Water Resources	Aquifer:
Date drilling completed: 6-20-16	P.0	. Box 2309	
Copy information from block on Part 1		MS 39225-2309) 961-5210	
	(601) 3	60-0535 (fax)	
This part of the report must be complete of the report must be attached and both Well Owner Informa	parts filed with the Depar	tment at the above address wit	
Owner Name: Edgar N. Donahoe, Jr.	·····	Latitude: 33 34' 12.2"	Longitude: 90 37' 56"
Mailing Address: 400 East Percy Stre	eet	Method of Lat/Long (check o	ne): 🔲 Conventional Survey,
		🔲 USGS quad, 🖾 Hand-he	ld GPS, 🔲 Survey-grade GPS
Indianola MS	38751	<u>NW</u> ¼ <u>NE</u> ¼	Sec <u>20</u> T <u>20N</u> R <u>4W</u>
City Star			
Telephone No. () -		Miles No (Distance) (Direc	rth of Indianola tion) (Nearest Town)
	Pump Type	(check one)	an a su a construction a free free free free free free free fr
🛛 Submersible 🗋 Turbine 🗋 Air Lift 🗋 🤅	Centrifugal 🗇 Flowing We	ell 🗇 Jet 🗇 Piston 🗇 Rotary 🖸] Other (describe):
Date Pump Installed 6-20-16	R	ated Pump Capacity: 600+/-	Gallons Per Minute
Is This Pump (check one): 🛛 New 🗌 Re			
		e (check one)	
Electric 🗋 Diesel 🗍 Gasoline 🗋 Natu	-	,	tanan Patin kana di kita di kita di kita di kana kana kana kana kana kana kana kan
Horse Power Rating of Motor: 15	Setting Depth: _	<u>/0 </u>	umber of Stages: 1
· · · · · · · · · · · · · · · · · · ·	Pump Test Data fo	r Non Flowing Well	,,,,,,, _
Date Well Tested:		-	num 4 hours): Hours
Static Water Level (A): Fe			
Drawdown [(B) - (A)]:			
Method of measurement (check one):			
		for Flowing Well	·
Measured shut in head:	Feet		
Well yielded GPM with	a drawdown of	feet after	hours of pumping
······	Meter In	stallation	
Meter Manufacturer:		Meter Serial Num Re Type of Meter:	
Meter Model Number/Name:		Type of Meter:	ceived
Totalizer Register Unit and Multiplier Fac	tor (AF x .001, gal x 1000		
Installation Date:	Meter installed by:	JU	N 2 9 2016
Is This Meter (check one): 🔲 New 🗌 Re	epaired 🗌 Replacement	Rv	
Important: By submitting the above For agricu		fying that this meter was insta oved meters is on the MDEQ w	
I HEREBY CERTIFY that the above stat	tements are true to the be	st of my knowledge.	\mathcal{D}
0695		6-24-16	Tan
Print Name of Pump Installer and Lice	nse No. (if applicable)	Date	Signature of Pump Installer

Form: OLWR-SWR-1B (4/13)

4. j