

SUNFLOWER

K 2000

3-17-77

MISSISSIPPI  
 BOARD OF WATER COMMISSIONERS  
 416 North State Street  
 Jackson, Mississippi 39201

WATER WELL DRILLERS LOG

3-17-77

BUTANE GAS CO. OF GREENWOOD

Sunflower

date well completed

firm name

county well located

LANDOWNER:	description of formations encountered	from	to
Vince Muzzi			
SHAW	SAND + Pea GRAVEL	15	84
(mailing address)	SAND	84	90
WELL LOCATION:	CLAY	90	104
sec. 9 T. 20 N. R. 4 E. S. 1 NW	SAND + CLAY	104	144
3 miles NW of Sunflower	SHALE	144	345
(distance) (direction) (nearest town)	SAND	345	380
WELL PURPOSE:	SHALE	380	424
(home, irrigation, municipal, industrial)	SAND	424	444
WELL COMPLETION DATA:	SHALE	444	480
(1) diameter (inches) 4 X 2	SAND	480	520
(2) total depth (feet) 798	SHALE + SAND	520	584
(3) static water level (feet) 18 below top of ground.	SAND	584	624
(4) casing Steel, 778 (material) (depth)	SHALE	624	776
4 X 2 If telescope see back. (size)	SAND	776	798
(5) screen 20' 778 (length) (depth to top)			
2" Stainless (size) (material)			
(6) pump 3/4 19 (HP) (yield gpm)			
Elec (type power)			
(7) electric log NO (yes or no)			
(organization running log)			
(8) how well bottom plugged BACK PRESSURE VALVE			
DRILLERS REMARKS:			

MAR 21 1977

MISS. BD. OF WATER COMMISSIONERS


If well telescopes please sketch and show depths.

GROUND LEVEL

105' - 4" CASING →

673' - 2" CASING →

20' - 2" SCREEN →

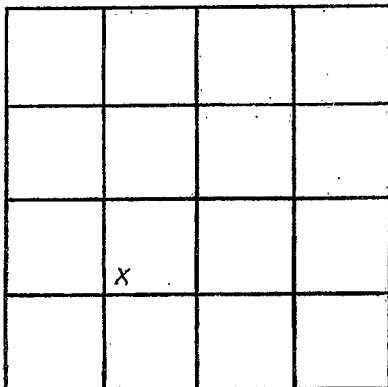

SECTION 9

Please indicate well location X.

ADDITIONAL INFORMATION

If more than one screen,  
show locations of each on sketch.