

MISSISSIPPI DEPARTMENT OF NATURAL RESOURCES

Bureau of Land and Water Resources

P.O. Box 10631

Jackson, Mississippi 39209

WATER WELL DRILLERS LOG

COUNTY WELL LOCATED  
*Sunflower*

WELL NUMBER  
*K2001*

CODED

PERMIT NUMBER

NAME OF DRILLING FIRM  
*Dyn Well*

DATE WELL COMPLETED  
*4-25-89*

NAME & MAILING ADDRESS OF LANDOWNER  
*J. V. SALLY*

WELL LOCATION: SEC *20* TOWNSHIP *N 4 W* RANGE *4*

DISTANCE *1* Miles DIRECTION *E* NEAREST TOWN *Steiner*

OTHER LANDMARK

WELL PURPOSE: Home, Irrigation, Municipal, Industrial, Fish Pond, etc.

PUMP DATA

PUMP TYPE (Circle One):  
Submersible, Turbine, Jet, Flowing Well, Other (Describe)

POWER TYPE (Circle One):  
Electric, Tractor, Diesel, Gasoline, Butane, Other (Describe)

Pump Capacity (GPM) *2000* No. of Stages *2* Setting Depth *60'* FT.

PUMP TEST

Well yielded \_\_\_\_\_ GPM with a drawdown of \_\_\_\_\_ ft. after \_\_\_\_\_ hours of pumping

WELL DATA

Well Depth *96'* Casing Diameter (In.) *16"* Casing Length (Ft.) *56'*

Type of Casing *steel* Hole Depth Depth to Static Water Level

TYPE OF COMPLETION: (Circle One or More):  
Gravel Packed, Underreamed, Telescoped, Natural Development, Open Hole, Other

Top of Lap Pipe or Reduction in Casing

FEET IF TELESCOPED OR MORE THAN ONE SCREEN: USE BACK PAGE

LOG DATA

TYPE OF LOG RUN (Circle One):  
Electric, Gamma Ray, Density, No Log Run, Sonic, Neutron, Other (Describe)

Name of Organization Running Log  
*None*

SCREEN DATA

Diameter - Inches *16"* Length - Feet *40'* Slot Size - Inches *.030*

Screen Type *Wire Wrap* Depth to Bottom - Feet

GEOLOGIC DATA (Office Use Only)

Surface Elev.	Geologic Unit	Unit Thickness	Depth to Top
Subs. SWL	Date	Analysis	Aquifer Test

Driller's Remarks

DESCRIPTION OF FORMATIONS ENCOUNTERED	FROM	TO	FORMATIONS (Continued)	FROM	TO
<i>Clay</i>	<i>0</i>	<i>28</i>			
<i>Fine Sand</i>	<i>28</i>	<i>38</i>			
<i>Fine Sand + Gravel</i>	<i>38</i>	<i>50</i>			
<i>M Sand + Gravel</i>	<i>50</i>	<i>60</i>			
<i>Sand + Gravel</i>	<i>60</i>	<i>70</i>			
<i>Fine Sand + Gravel</i>	<i>70</i>	<i>75</i>			
<i>Sand + Gravel</i>	<i>75</i>	<i>96</i>			
<i>Fine Sand + Gravel</i>	<i>96</i>	<i>102</i>			


APR 28 1989

Department of Natural Resources  
Bureau of Land & Water Resources

IF MORE SPACE IS NEEDED, USE BACK

If well telescopes please  
sketch and show depths.

GROUND LEVEL

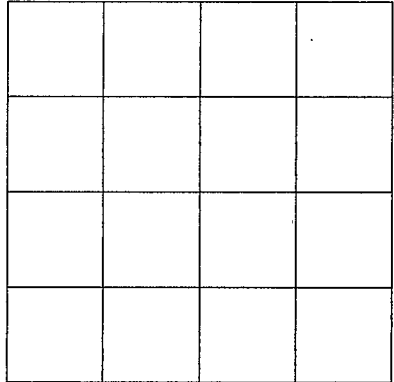

SECTION \_\_\_\_\_

Please indicate well location X.

ADDITIONAL INFORMATION

If more than one screen,  
show location of each on sketch.