

MISSISSIPPI DEPARTMENT OF ENVIRONMENTAL QUALITY

Office of Land and Water Resources

P. O. Box 10631
Jackson, MS 39289-0631
WATER WELL DRILLERS LOG

COUNTY WELL LOCATED Sunflower	
WELL NUMBER R 2023	CODED
DATE WELL COMPLETED 6-28-96	

PERMIT NUMBER
NAME OF DRILLING FIRM Irrigation Equipment
Indianola, MS

NAME & MAILING ADDRESS OF LANDOWNER C&M Land Co. LLC		
Box 708		
Indianola, MS 38751		
WELL LOCATION: SEC	TOWNSHIP	RANGE
18	20N N S	4W E W
DISTANCE	DIRECTION	NEAREST TOWN
8 Miles	North	Indianola
OTHER LANDMARK		
WELL PURPOSE: Home, Irrigation, Municipal, Industrial, Fish Pond, etc. Fish Pond		

PUMP DATA		
PUMP TYPE (Circle One): Submersible, Turbine? Jet Flowing Well, Other (Describe)		
POWER TYPE (Circle One): Electric Tractor, Diesel, Gasoline, Butane, Other (Describe) 30 H/P		
Pump Capacity (GPM)	No. of Stages	Setting Depth
1500	2	60 FT.
PUMP TEST		
Well yielded _____ GPM with a drawdown of _____ ft. after _____ hours of pumping		

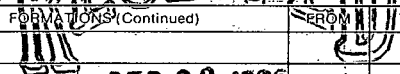
WELL DATA		
Well Depth	Casing Diameter (In.)	Casing Length (Ft.)
120	12	80
Type of Casing	Hole Depth	Depth to Static Water Level
PVC	120	35 ft.
TYPE OF COMPLETION: (Circle One or More): Gravel Packed , Underreamed, Telescoped, Natural Development, Open Hole, Other (Describe)		
WELL GROUTED TO A DEPTH OF _____ FEET Type Grout (circle one): Cement, Bentonite, or Mix		

LOG DATA	
TYPE OF LOG RUN (Circle One): No Log Run, Electric, Gamma Ray, Density, Sonic, Neutron, Other (Describe)	
Name of Organization Running Log	

SCREEN DATA		
Diameter - Inches	Length - Feet	Slot Size - Inches
12	40	.030
Screen Type	Depth to Bottom - Feet	
PVC	120	

GEOLOGIC DATA (Office Use Only)			
Surface Elev.	Geologic Unit	Unit Thickness	Depth to Top
Subs. SWL	Date	Analysis	Aquifer Test
Driller's Remarks			
Top of Lap Pipe or Reduction in Casing			

DESCRIPTION OF FORMATIONS ENCOUNTERED	FROM	TO
Clay	0	40
Fine Sand	40	50
Fine Sand & Gravel	50	80
Med. Sand & Gravel	80	120

FORMATIONS (Continued)	
FROM TO	
	
SEP 23 1996	
Dept. of Environmental Quality Office of Land & Water Resources	
IF MORE SPACE IS NEEDED, USE BACK	

If well telescopes please
sketch and show depths.

GROUND LEVEL

			X

SECTION 18

Please indicate well location X.

ADDITIONAL INFORMATION

If more than one screen,
show location of each on sketch.