

SUNF. MISSISSIPPI BOARD OF WATER COMMISSIONERS

L11
8-13-60

WATER WELL DRILLERS LOG

CODED L-

Date: 8-13, 1960, Driller: PUTA DEL GAS Co of G. WOOD County *Sunflower*

(Name)

(1) Owner of Land: KELLY FISACKERLY

(Name)

SUNFLOWER, MISS.

(Address)

(2) Location: 1/4, 1/4, Sec. 15 20 3 R

6 miles NEAST, of SUNFLOWER
(distance) (direction) (Nearest Town)

(3) Topography: LEVEL

(Hilly) (Flat) (Level)

(4) Purpose of Well: IRRIGATION

(Domestic Irrigation
Municipal, Industrial, Other)

Information upon completion of well:

(1) Diameter 12 inches.

(2) Total Depth 94 feet.

(3) Water Level 16 feet below top of ground.

(4) Cased to 58, Size 12"

(5) Screen: Size 12", Length 36'

(6) Were any formations sealed against pollution?

yes, X no.

If YES depth of formation _____

Why _____

Drillers Remarks: NONE


Description & Color of Materials
Sand, Clay, Red Clay, Shell, etc.

Thick-
ness
Feet

Depth
Feet

CLAY	43	43
SAND (SILTY)	9	52
PEA ROCK + SAND	21	73
ROCK (GRAVEL)	21	94

CODED

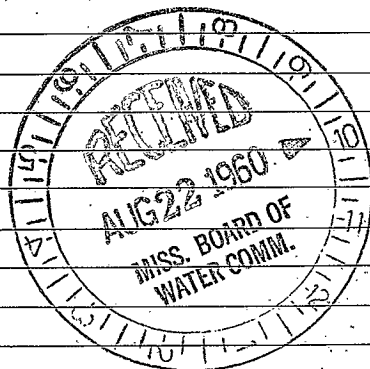

(Use Back Side)

Well No.

