

SUNFLOWER

L 14

2-7-69

MISSISSIPPI  
 BOARD OF WATER COMMISSIONERS  
 416 North State Street  
 Jackson, Mississippi 39201

WATER WELL DRILLERS LOG

2-7  
date well completed

1969 DYER Well Trv Ser  
firm name

~~SUNFLOWER~~  
SUNFLOWER  
county well located

LANDOWNER: ~~...~~

Morgan Grubbs

SUNFLOWER Miss  
(mailing address)

WELL LOCATION:

sec 34 T 20 N R 3 E  
3 miles N.E. of SUNFLOWER  
(distance) (direction) (nearest town)

WELL PURPOSE: IRRIG  
(home, irrigation, municipal, industrial)

WELL COMPLETION DATA:

- (1) diameter (inches) 16"
- (2) total depth (feet) 123'
- (3) static water level (feet) 18' below above top of ground.
- (4) casing BIKIR 83'  
(material) (depth)  
16" If telescope see back.  
(size)
- (5) screen 40' 83'  
(length) (depth to top)  
16" BLK IR  
(size) (material)
- (6) pump 50 2500  
(HP) (yield gpm)  
DIESEN  
(type power)
- (7) electric log no  
(yes or no)
- (organization running log)
- (8) how well bottom plugged PIATE

DRILLERS REMARKS:

description of formations encountered

from to


Clay	0	13
Clay and Fine Sand	13	23
Blue Clay and Fine Sand	23	33
" " " "	33	43
Coarse Sand	43	53
" " Gravel	53	63
" " " "	63	73
" " " "	73	83
Fine Sand	83	93
" " "	93	103
Coarse Sand & Gravel	103	113
" " "	113	123

NEAR 18 1009

MISC. ELL. OR WATER GAGE

If well telescopes please sketch and show depths.

GROUND LEVEL

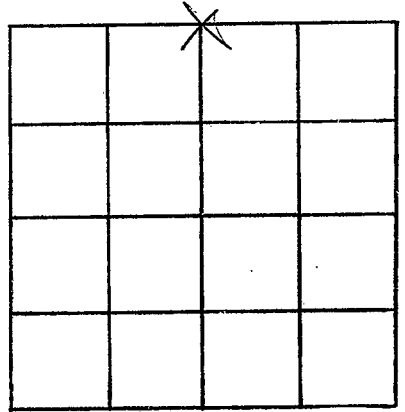

SECTION 34

Please indicate well location X.

ADDITIONAL INFORMATION

If more than one screen, show locations of each on sketch.