

14

Sunflowers
L17
5-22-69

MISSISSIPPI
BOARD OF WATER COMMISSIONERS
416 North State Street
Jackson, Mississippi 39201

#CODED

WATER WELL DRILLERS LOG

DYER WELL & IRRIGATION SERVICE

SUNFLOWER

5-22-69 19
date well completed

firm name

county well located

LANDOWNER:

MILTON JEFFCOAT

SUNFLOWER, MISS.
(mailing address)

description of formations encountered

from

to

Clay	0	13
Clay	13	23
Fine Sand	23	33
✓	33	43
✓	43	53
Med. Sand	53	63
Coarse Sand & Gravel	63	73
✓	73	83
4' Fine Sand & Gravel	83	93
Coarse Sand & Gravel	93	103

WELL LOCATION:

sec. 31 T20N R3E
3 miles N.W. of SUN-F
(distance) (direction) (nearest town)

WELL PURPOSE: F131D
(home, irrigation, municipal, industrial)

WELL COMPLETION DATA:

- (1) diameter (inches) 12"
- (2) total depth (feet) 103'
- (3) static water level (feet) 19' below top of ground.
- (4) casing BLK IR, 63' (material) (depth)
12" (size) if telescope see back.
- (5) screen 40' 63' (length) (depth to top)
12" BLK INGT (size) (material)
- (6) pump 33 1800 (HP) (yield gpm)
BNTAWC (type power)
- (7) electric log No (yes or no)

CODED

(organization running log)

(8) how well bottom plugged PLATE


APR 23 1969

MISS. BD. OF WATER COM.

DRILLERS REMARKS:

If well telescopes please sketch and show depths.

GROUND LEVEL

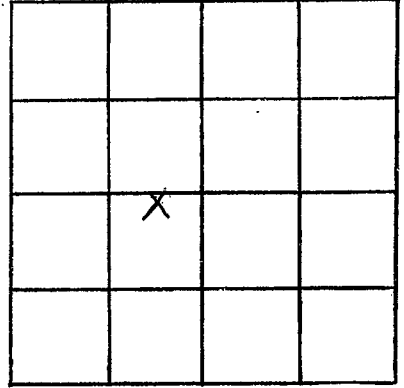

SECTION 31

Please indicate well location X.

ADDITIONAL INFORMATION

If more than one screen,
show locations of each on sketch.