

Sunflower
L 19.
7-15-69

MISSISSIPPI
BOARD OF WATER COMMISSIONERS
416 North State Street
Jackson, Mississippi 39201

CODED

WATER WELL DRILLERS LOG

July 15 1969 **DYER WELL & IRRIGATION SERVICE** Sunflower
date well completed firm name County well located

LANDOWNER:
MRS RYBVE MORGAN & SONS
SUNFLOWER MISS
(mailing address)

description of formations encountered	from	to
Clay	0	13
Light Sand Blue Clay	13	43
Brown Coarse Sand	23	33
Coarse Sand & Gravel	33	43
	43	53
	53	63
	63	73
	73	83
Coarse Sand 5' Fine Sand	83	93

WELL LOCATION:
sec. 23 T. 20N R. 3 E
5 miles N.E. of Sunflower
(distance) (direction) (nearest town)

WELL PURPOSE: IRRIGATION
(home, irrigation, municipal, industrial)

WELL COMPLETION DATA:

(1) diameter (inches) 16
(2) total depth (feet) 88
(3) static water level (feet) 19 below above top of ground.
(4) casing BUCING 48 (material) (depth) 16" (size) If telescope see back.
(5) screen 40' 48' (length) (depth to top) 16" BUCING (size) (material)
(6) pump 35 1800 (HP) (yield gpm) TRACTOR (type power)
(7) electric log No (yes or no)
(organization running log)
(8) how well bottom plugged PLATE

CODED


JUL 23 1969

DRILLERS REMARKS:

MISS. DEPT. OF WATER CONTROL

If well telescopes please
sketch and show depths.

GROUND LEVEL

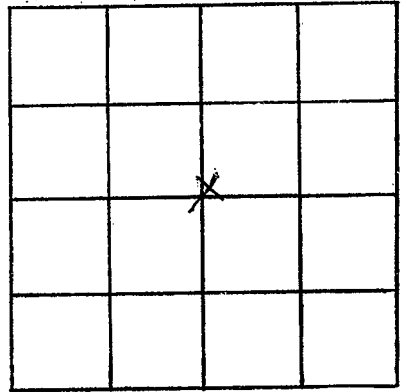

SECTION 23

Please indicate well location X.

ADDITIONAL INFORMATION

If more than one screen,
show locations of each on sketch.