

CODED

RL23

7-6-62

WATER WELL DRILLERS LOG

Sunflower

Date: 7-6, 1962, Driller: Brian Gasco or Wood County: FEFERS

(Name)

(1) Owner of Land: M. W. JEFFCOAT
(Name)

SUNFLOWER, MISS
(Address)

(2) Location: 1/4, 1/4, Sec. 31 T R
3

5 miles NW of SUNFLOWER
(distance) (direction) (Nearest Town)

(3) Topography: FLAT
(Hilly) (Flat) (Level)

(4) Purpose of Well: IRRIGATION
(Domestic Irrigation
Municipal, Industrial, Other)

Description & Color of Materials
Sand, Clay, Red Clay, Shell, etc.

Thick-
ness
Feet

Depth
Feet

CLAY (BLUE)	14	14
PEA GRAVEL & GRAVEL	17	31
SAND	25	56
PEA GRAVEL	15	71
PEA GRAVEL & GRAVEL	35	106

Information upon completion of well:

(1) Diameter: 12" inches.

(2) Total Depth: 106 feet.

(3) Water Level: 15'-8" feet below top of ground.

(4) Cased to: 58', Size: 12 3/4"

(5) Screen: Size 12", Length 48'


(6) Were any formations sealed against pollution?
_____ yes, X no.

If YES depth of formation _____

Why _____

Drillers Remarks: _____

CODED

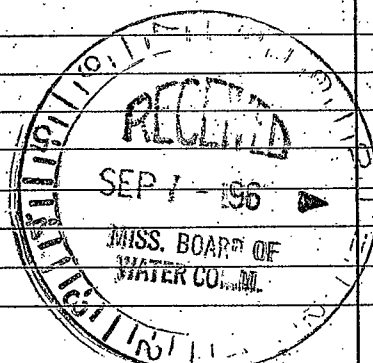

(Use Back Side)

Well No.

