

SUNFLOWER

L 25

9-17-64

WATER WELL DRILLERS LOG

CODED

Date: 9/17, 1964, Driller: Bailey Drlg. Co. County: Washington (Name)

(1) Owner of Land: Robt Mullens
 (Name)
Blaine, Miss.
 (Address)

(2) Location: 1/4, 1/4, Sec. 10 T20R3
2 miles E of Blaine
 (distance) (direction) (Nearest Town)

(3) Topography: Flat
 (Hilly) (Flat) (Level)

(4) Purpose of Well: Domestic
 (Domestic Irrigation
 Municipal, Industrial, Other)

Description & Color of Materials Sand, Clay, Red Clay, Shell, etc.	Thick- ness Feet	Depth Feet
Clay		20
Sand		80
Gravel		160
Mud + rocks		1480
Sand		1495
Mud		1540
Sand		1558

Information upon completion of well:

(1) Diameter 4 X 3 inches.

(2) Total Depth 1558 feet.

(3) Water Level 20 feet above ground.

(4) Cased to all way, Size 4 X 2.

(5) Screen: Size 3, Length 30ft.


(6) Were any formations sealed against pollution?
 ___ yes, X no.

CODED

If YES depth of formation _____

Why _____

Drillers Remarks: _____

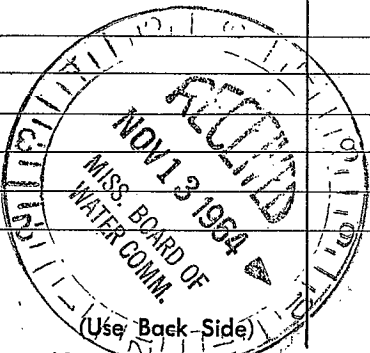

Well No.

