

SUNF. MISSISSIPPI BOARD OF WATER COMMISSIONERS

208 L 26
7-23-60

USGS = 2026

WATER WELL DRILLERS LOG

CODED ^{Key L}

Sunflower

Date: 7-23, 1960; Driller: PURANE GAS CO. OF G. WOOD County

(Name)

(1) Owner of Land: A. W. JEFFCOAT

(Name)

SUNFLOWER, MISS.

(Address)

(2) Location: 1/4, 1/4, Sec. 31 T20R3

3 miles N-WEST, of SUNFLOWER
(distance) (direction) (Nearest Town)

(3) Topography: LEVEL
(Hilly) (Flat) (Level)

(4) Purpose of Well: IRRIGATION
(Domestic Irrigation
Municipal, Industrial, Other)

Information upon completion of well:


- (1) Diameter 16 inches.
- (2) Total Depth 93 feet.
- (3) Water Level 17 feet below top of ground.
- (4) Cased to 57 FT., Size 16
- (5) Screen: Size 12", Length 36'
- (6) Were any formations sealed against pollution?
yes, X no.

If YES depth of formation _____
Why _____

Drillers Remarks: BLUE CLAY
BACK IN STRATA AT
93 FT. PULLED BOTTOM
OF WELL BACK TO 93 FT.

Description & Color of Materials Sand, Clay, Red Clay, Shell, etc.	Thickness Feet	Depth Feet
<u>CLAY (BUCKSHOT)</u>	<u>23</u>	<u>23</u>
<u>SAND (SILTY)</u>	<u>21</u>	<u>44</u>
<u>SAND + PEA GRAVEL</u>	<u>11</u>	<u>55</u>
<u>LARGE ROCK PEA GRAVEL</u>	<u>38</u>	<u>93</u>
<u>BLUE CLAY</u>	<u>5</u>	<u>98</u>

CODED

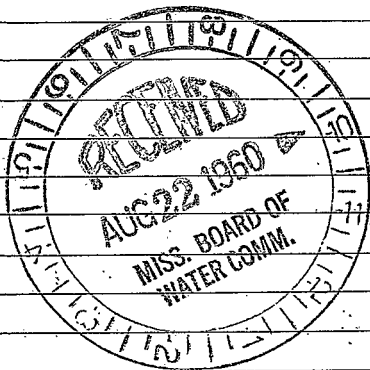

(Use Back Side)

Well No.

1941

1941

