

SUNFLOWER
L 28
3-27-73

MISSISSIPPI
BOARD OF WATER COMMISSIONERS
1000 416 North State Street
Jackson, Mississippi 39201

CODED

WATER WELL DRILLERS LOG

March 27 1973 DYER WELL & IRRIGATION SERVICE SUNFLOWER
date well completed firm name county well located

LANDOWNER: Morgan Brothers

description of formations encountered

from to

SUNFLOWER

CLAY
SAND CLAY
SAND GRAVEL

0 18
18 33
33 103

M 1327

(mailing address)

WELL LOCATION:

sec. 35 T 20 N R 3 W
1 1/2 miles NE. of SUNFLOWER
(distance) (direction) (nearest town)

WELL PURPOSE: IRR.
(home, irrigation, municipal, industrial)

WELL COMPLETION DATA:

- (1) diameter (inches) 16"
- (2) total depth (feet) 103'
- (3) static water level (feet) 17' below top of ground.
- (4) casing BUTIR 63' (material), (depth)
16" (size) if telescope see back.
- (5) screen 40' 63' (length), (depth to top)
16" BUTIR IN 605 (size), (material)
- (6) pump 50 2500 (HP), (yield gpm)
EVEL (type power)
- (7) electric log NO (yes or no)

CODED

(organization running log)

(8) how well bottom plugged PLATE


JUN 27 1973

DRILLERS REMARKS:

MIS. 200
WATER

If well telescopes please sketch and show depths.

GROUND LEVEL

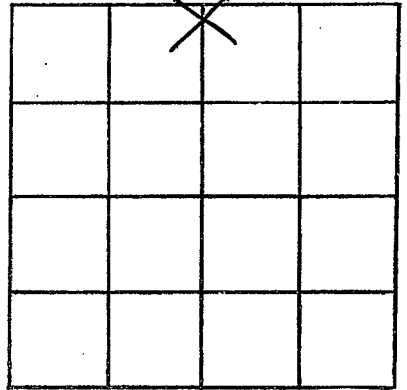

SECTION 35

Please indicate well location X.

ADDITIONAL INFORMATION

If more than one screen, show locations of each on sketch.