

SUNFLOWER
L 29.
3-18-73

MISSISSIPPI
BOARD OF WATER COMMISSIONERS
416 North State Street
Jackson, Mississippi 39201

CODED

WATER WELL DRILLERS LOG

March 18 19 73 **DYER WELL & IRRIGATION SERVICE** *SUNFLOWER*
date well completed firm name county well located

LANDOWNER: *Morgan Brothers*

description of formations encountered

from to

SUNFLOWER

Clay

0 30

Miss.

Fine Sand

30 58

(mailing address)

Sand GRAVEL

58 113

WELL LOCATION:

sec. *27* T. *00* N. R. *3* E. W. *W*
2 1/2 miles *NE* of *SUNFLOWER*
(distance) (direction) (nearest town)

WELL PURPOSE: *IRRI.*
(home, irrigation, municipal, industrial)

WELL COMPLETION DATA:

CODED


- (1) diameter (inches) *16"*
- (2) total depth (feet) *113'*
- (3) static water level (feet) *17'* below above top of ground.
- (4) casing *BURTR*, *73'*
(material) (depth)
16" if telescope see back.
(size)
- (5) screen *40'*, *73'*
(length) (depth to top)
16", *BUR INBOT*
(size) (material)
- (6) pump *35* *1800*
(HP) (yield gpm)
DIESEL
(type power)
- (7) electric log *N/O*
(yes or no)
- (organization running log)
- (8) how well bottom plugged *PLATE*

DRILLERS REMARKS:

JUN 27 1973

If well telescopes please sketch and show depths.

GROUND LEVEL

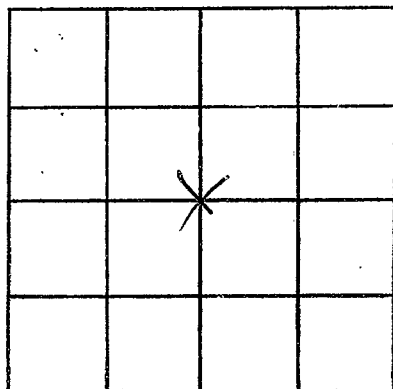

SECTION 27

Please indicate well location X.

ADDITIONAL INFORMATION

If more than one screen,
show locations of each on sketch.