

GW 10471
 SW/NE, Sec. 18
 Elev. 124

SUNFLOWER
L 30
2-9-74

MISSISSIPPI
 BOARD OF WATER COMMISSIONERS
 416 North State Street
 Jackson, Mississippi 39201

CODED

WATER WELL DRILLERS LOG

2-9 1974 **DYER WELL & IRRIGATION SERVICE** **SUNFLOWER**
 date well completed firm name county well located

LANDOWNER: **ZARNER ARANT**
BLAINE
Miss.
 (mailing address)

description of formations encountered	from	to
CLAY	0	19
SAND	19	42
PEA ROCK SAND	42	61
PEA ROCK GRAVEL	61	113

WELL LOCATION:
 sec. 18 T. 20 N R. 3 W
 2 miles W of **BLAINE**
 (distance) (direction) (nearest town)

WELL PURPOSE: **IRR**
 (home, irrigation, municipal, industrial)

- WELL COMPLETION DATA:
- (1) diameter (inches) 16"
 - (2) total depth (feet) 113
 - (3) static water level (feet) 17' below top of ground.
 - (4) casing BUCK, 63'
 (material) (depth)
16" If telescope see back.
 (size)
 - (5) screen 48', 63'
 (length) (depth to top)
16", BUCK IN 60T
 (size) (material)
 - (6) pump 60 3000
 (HP) (yield gpm)
ELEC.
 (type power)
 - (7) electric log NO
 (yes or no)
 - (organization running log)
 - (8) how well bottom plugged PLATE

CODED

DRILLERS REMARKS:


FEB 14 1974

MISS. DE. OF

7MM

If well telescopes please sketch and show depths.

GROUND LEVEL

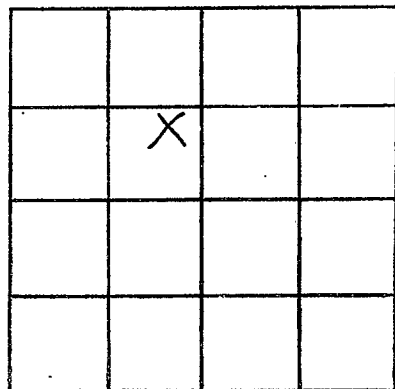

SECTION 18

Please indicate well location X.

ADDITIONAL INFORMATION

If more than one screen,
show locations of each on sketch.