

If well telescopes please sketch and show depths.

GROUND LEVEL

100' 4" BLK
A.R.I. LINE
PIPE

500' 3" BLK A.P.
I. LINE PIPE

25' LAP OF
2" IN 3" PIPE


474' 2" BLK
API LINE PIPE

10' 2" STAINLESS
STEEL SCREEN

48' 2" BLK A.R.I.
LINE PIPE

10' 2" STAINLESS
STEEL SCREEN

98' 2" BLK A.R.I.
LINE PIPE
ON BOTTOM

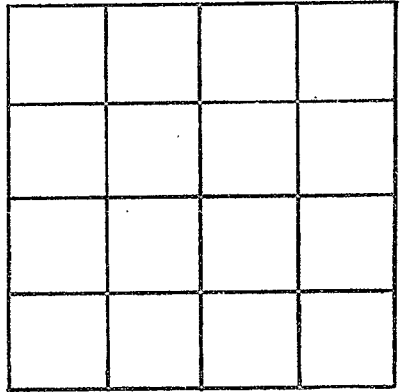

SECTION 32

Please indicate well location X.

ADDITIONAL INFORMATION

If more than one screen,
show locations of each on sketch.