

**MISSISSIPPI
BOARD OF WATER COMMISSIONERS**
416 North State Street
Jackson, Mississippi 39201

WATER WELL DRILLERS LOG

Sunflower
L 33
5-67
Elec Log

MAY 30 1967 DELTA DRILLING Co. SUN FLOWER
date well completed firm name county well located

LANDOWNER: TURNER ARANT

DODDSDVILLE, MISS.

(mailing address)


WELL LOCATION: NE 1/4 SE 1/4 NE 1/4
sec. 8 T 20 N R 3 E
3 miles S of Doddsville
(distance) (direction) (nearest town)

WELL PURPOSE:
(home, irrigation, municipal, industrial)

WELL COMPLETION DATA:

- (1) diameter (inches) 4
- (2) total depth (feet) 1068
- (3) static water level (feet) FLOWS ^{below} above top of ground.
- (4) casing BLK STEEL 1048
(material) (depth)
4.3+2" if telescope see back.
(size)
- (5) screen 20' 842
(length) (depth to top)
2" STAINLESS STEEL
(size) (material)
- (6) pump 1 1800
(HP) (yield gph)
ELEC
(type power)
- (7) electric log YES
(yes or no)
GEOLOGICAL SURVEY
(organization running log)
- (8) how well bottom plugged BACK
PRESSURE VALVE

description of formations encountered	from	to
GUMBO	0	13
Sand	13	95
gravel	95	124
gumbo	124	130
Sand	130	179
gumbo	179	186
Shale	186	238
Sand	238	401
Shale	401	430
gumbo	430	550
Shale	550	595
gumbo	595	615
Sand	615	683
Shale	683	720
gumbo	720	777
green sand	777	826
Shale	826	844
green sand w/ROCK	844	870
Shale	870	917
green sand w/ROCK	917	995
Shale	995	1005
Sand	1005	1062
Shale	1062	1068

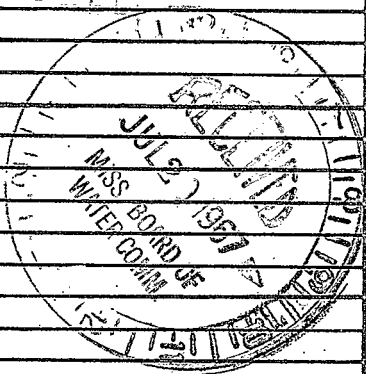

DRILLERS REMARKS: 220941

TANK - 42' SETTING IN WELL

If well telescopes please sketch and show depths.

GROUND LEVEL

75' 4" BLK
API LINE PIPE

525' 3" BLK
API LINE PIPE

24' LAP OF
2" IN 3" PIPE

266' 2" BLK
API LINE PIPE

842'
10' 2" S.S.
SCREEN


200' 2" BLK
API LINE PIPE

10' 2" S.S.
SCREEN

6' 2" BLK
API LINE PIPE

2" BP VALVE

1068 T.D.

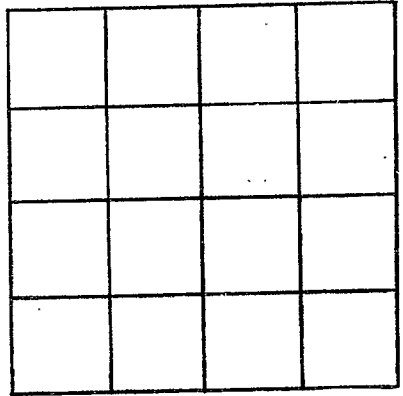

SECTION 8

Please indicate well location X.

ADDITIONAL INFORMATION

If more than one screen,
show locations of each on sketch.