

Sunflower

L 34

4-67

MISSISSIPPI
 BOARD OF WATER COMMISSIONERS
 416 North State Street
 Jackson, Mississippi 39201
 WATER WELL DRILLERS LOG

4/18 19 67 Dyer Well & Irrigation Sunflower
 date well completed firm name county well located

LANDOWNER: Mrs. Rubye Morgan
 Sunflower
 Miss.
 (mailing address)


description of formations encountered	from	to
Clay	0	23
Med. Sand	23	53
Coarse Sand	53	83
Coarse sand & Gravel	83	93

WELL LOCATION:
 sec. 25 T. 20 N R. 3 E
 S W
 Five miles N. E. of Sunflower
 (distance) (direction) (nearest town)

WELL PURPOSE: Irrigation
 (home, irrigation, municipal, industrial)

- WELL COMPLETION DATA:
- (1) diameter (inches) 18" 12"
 - (2) total depth (feet) 93 Kkft.
 - (3) static water level (feet) 17 below above top of ground.
 - (4) casing pipe 53 Blk. Iron (material) (depth)
 - (size) if telescope see back.
 - (5) screen 40 Rt, 53 (length) (depth to top)
 12" Blk. Iron (Doerr) (size) (material)
 - (6) pump 35 2,000 (HP) (yield gpm)
 Diesel (type power)
 - (7) electric log No (yes or no)
 (organization running log)
 - (8) how well bottom plugged Plate welded on bottom

DRILLERS REMARKS:

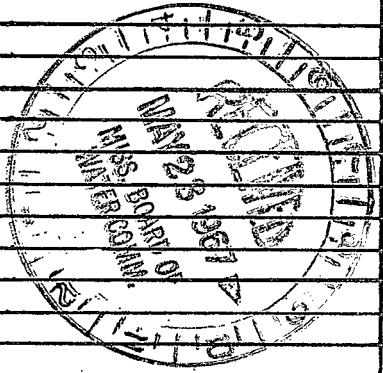

If well telescopes please sketch and show depths.

GROUND LEVEL

	X		

SECTION 25

Please indicate well location X.

ADDITIONAL INFORMATION

If more than one screen, show locations of each on sketch.