

SUNF. MISSISSIPPI BOARD OF WATER COMMISSIONERS

L 9
act 108

L 36

10-29-65 WATER WELL DRILLERS LOG

Sunflower

Date: OCT 29, 1965, Drillers: DELTA DRILLING Co County: LEFLORE
(Name)

TELSTAR PLANTATION -
(1) Owner of Land: J. S. PARKER
(Name)
GREENWOOD, MISS
(Address)
(2) Location: SW 1/4, NW 1/4, Sec. 6 ^{20N} ~~21N~~ TR 3W
_____ miles _____ of _____
(distance) (direction) (Nearest Town)
(3) Topography: _____
(Hilly) (Flat) (Level)
(4) Purpose of Well: Domestic
(Domestic Irrigation
Municipal, Industrial, Other)


Description & Color of Materials Sand, Clay, Red Clay, Shell, etc.	Thick- ness Feet	Depth Feet
Sand	62	62
gravel	62	124
Sand	43	167
gumbo	12	179
Sand	23	202
gumbo	34	236
Sand	18	254
Shale	34	288
gumbo	32	320
Sand	133	453
gumbo	59	512
Shale	28	540
gumbo	12	552
Sand	98	650
Shale	22	672
Sand	72	744
gumbo	24	778
Shale	12	790
gumbo	35	825
Sand w/ Rock	33	858
Shale w/ ROCKS	43	901
gumbo	10	911
Shale	29	940
Sand	46	986
Shale	12	998
Sand w/ ROCK	173	1171
gumbo	34	1205
Sand w/ ROCKS	103	1308
Shale	53	1361
Sand	102	1463

Information upon completion of well:

(1) Diameter 3 inches.
(2) Total Depth 1463 feet.
(3) Water Level FLOWS feet below top of ground.
(4) Cased to 1425, Size 880' - 3" ^{880' - 3"} 582' - 2"
(5) Screen: Size 2", Length 20.
(6) Were any formations sealed against pollution?
_____ yes, _____ no.

If YES depth of formation _____
Why _____

Drillers Remarks: 19' LAP OF 2" IN
3" pipe - 18' - 2" Tail
pipe on bottom end of
well.

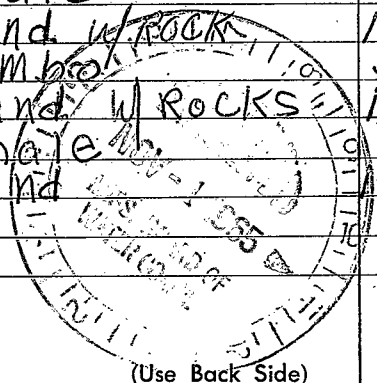

Well No.

(Use Back Side)

