

L 38
8-60

WATER WELL DRILLERS LOG

Date: Aug, 1960, Driller: Delta Wells Supply Co. Safford

(Name)

(1) Owner of Land: J.E. Dattle
(Name)
Ruleville.
(Address)

(2) Location: SE 1/4, SE 1/4, Sec. 32 T20R3
1 1/2 miles East, of Dundlow
(distance) (direction) (Nearest Town)

(3) Topography: Level
(Hilly) (Flat) (Level)

(4) Purpose of Well: Irrigation
(Domestic Irrigation
Municipal, Industrial, Other)

Description & Color of Materials Sand, Clay, Red Clay, Shell, etc.	Thick- ness Feet	Depth Feet
<u>Top soil sand clay.</u>	<u>15</u>	<u>15</u>
<u>Fine sand</u>	<u>20</u>	<u>35</u>
<u>1 course "</u>	<u>7</u>	<u>42</u>
<u>Blue clay</u>	<u>6</u>	<u>48</u>
<u>Fine sand</u>	<u>18</u>	<u>66</u>
<u>sand clay</u>	<u>4</u>	<u>70</u>
<u>" Medium</u>	<u>10</u>	<u>80</u>
<u>" gravel fine</u>	<u>22</u>	<u>102</u>
<u>" "</u>	<u>20</u>	<u>122</u>

Information upon completion of well:

(1) Diameter 10 inches.

(2) Total Depth 122 feet.

(3) Water Level 19 feet below top of ground.

(4) Cased to _____, Size _____.


(5) Screen: Size 10 in, Length 39 ft.

(6) Were any formations sealed against pollution?
_____ yes, no.

If YES depth of formation _____

Why _____

Drillers Remarks: _____

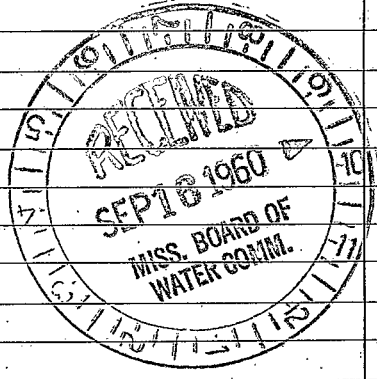

(Use Back Side)

Well No.

