

SUNF.

MISSISSIPPI BOARD OF WATER COMMISSIONERS

L-301

L 39

8-60

WATER WELL DRILLERS LOG

Date: aug, 1960, Driller: Datta Wells Supply Co County: sunflow
(Name)

- (1) Owner of Land: J. E. Datta
(Name)
Ruleville
(Address)
- (2) Location: NE 1/4, NE 1/4, Sec 33 T20R30N
2 miles N.E., of sunflow
(distance) (direction) (Nearest Town)
- (3) Topography: Level
(Hilly) (Flat) (Level)
- (4) Purpose of Well: Irrigation
(Domestic, Irrigation, Municipal, Industrial, Other)

Description & Color of Materials
Sand, Clay, Red Clay, Shell, etc.Thick-
ness
FeetDepth
Feet

<u>sand clay</u>	<u>16</u>	<u>16</u>
" <u>fine</u>	<u>3</u>	<u>19</u>
" <u>clay</u>	<u>28</u>	<u>47</u>
" <u>gravel</u>	<u>8</u>	<u>55</u>
" <u>fine</u>	<u>10</u>	<u>65</u>
" <u>gravel</u>	<u>15</u>	<u>80</u>
" <u>fine</u>	<u>18</u>	<u>98</u>
" <u>course</u>	<u>20</u>	<u>119</u>
" <u>gravel course</u>	<u>3</u>	<u>121</u>


Information upon completion of well:

- (1) Diameter 8 inches.
- (2) Total Depth 121 feet.
- (3) Water Level 20 feet below top of ground.
- (4) Cased to _____, Size _____.
- (5) Screen: Size 8 in, Length 37.
- (6) Were any formations sealed against pollution?
_____ yes, no.

If YES depth of formation _____.

Why _____.

Drillers Remarks: _____.

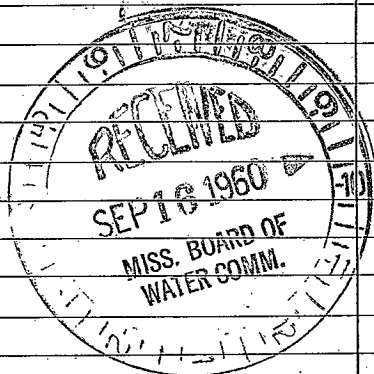

(Use Back Side)

Well No.

