

MISSISSIPPI  
BOARD OF WATER COMMISSIONERS  
416 North State Street  
Jackson, Mississippi 39201

CODED

WATER WELL DRILLERS LOG


SUNFLOWER  
L 40  
3-11-75

March 11, 1975 Dyer-Sullivan, Inc. Sunflower  
date well completed firm name county well located

LANDOWNER: Billy Joe Lovett Ruleville, Miss.	description of formations encountered	from	to
(mailing address)	Clay FINE SAND SAND & GRAVEL	0 28 71	28 71 111
WELL LOCATION: sec 28 T 20 N R 3 E 15# S W 1/2 miles NE of Sunflower (distance) (direction) (nearest town)			
WELL PURPOSE: Irrigation (home, irrigation, municipal, industrial)			
WELL COMPLETION DATA:			
(1) diameter (inches) 16"			
(2) total depth (feet) 111'			
(3) static water level (feet) 11' below top of ground.			
(4) casing BK Iron, 111' (material) (depth) 16" (size) if telescope see back.			
(5) screen 40' 71' (length) (depth to top) 16" BK Ingot (size) (material)			
(6) pump 60 3000 (HP) (yield gpm) Diesel (type power)			
(7) electric log No (yes or no)			
(organization running log)			
(8) how well bottom plugged Plate			
DRILLERS REMARKS:			
	MISS. Bd. OF WATER COMMISSIONERS		

If well telescopes please sketch and show depths.

GROUND LEVEL

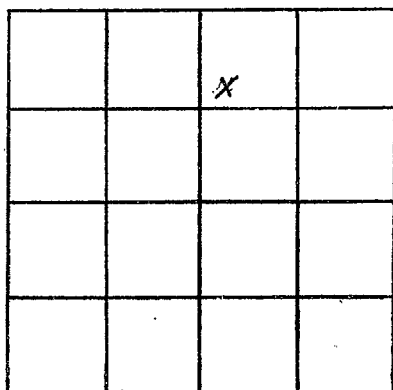

SECTION 28

Please indicate well location X.

ADDITIONAL INFORMATION

If more than one screen,  
show locations of each on sketch.