

SUNFLOWER
L41
10-25-75

MISSISSIPPI
BOARD OF WATER COMMISSIONERS
416 North State Street
Jackson, Mississippi 39201

WATER WELL DRILLERS LOG

CODED

OCT 25 1975 Dyet - Sullivan Sunflower
date well completed firm name county well located

LANDOWNER: TOPAUGA FARMS

description of formations encountered

from to

P.O. Box 367

Shaw, Miss
(mailing address)

CLAY	0	44
Fine SAND	44	50
SAND & GRAVEL	50	103

WELL LOCATION:

sec. 33 T. 20 N R. 3 E
& W
1 miles E of SUNFLOWER
(distance) (direction) (nearest town)

elev. 120

WELL PURPOSE: INVESTIGATION
(home, irrigation, municipal, industrial)

WELL COMPLETION DATA:

- diameter (inches) 12"
- total depth (feet) 103'
- static water level (feet) 17' below top of ground. above
- casing BLKINSOT 63'
(material) (depth)
12"
(size) if telescope see back.
- screen 40' 63'
(length) (depth to top)
12" Dyeat - Sullivan frame
(size) (material)
- pump 40 1800
(HP) (yield gpm)
Diesel
(type power)
- electric log NO
(yes or no)
- (organization running log)
- how well bottom plugged PIATE

CODED


DRILLERS REMARKS:

DEC 28 1975

MISS. BD. OF WATER

If well telescopes please sketch and show depths.

GROUND LEVEL

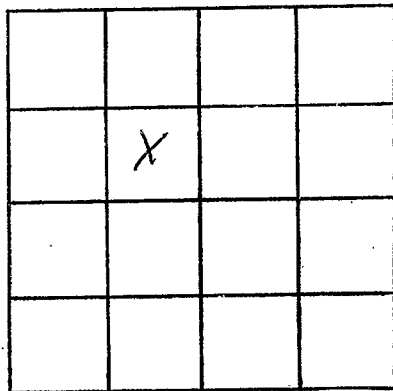

SECTION _____

Please indicate well location X.

ADDITIONAL INFORMATION

If more than one screen,
show locations of each on sketch.