

SUNFLOWER

L 42

10-28-75

MISSISSIPPI
 BOARD OF WATER COMMISSIONERS
 416 North State Street
 Jackson, Mississippi 39201

CODED

WATER WELL DRILLERS LOG

OCT 28

1975 Dyer-Sullivan

Sunflower

date well completed

firm name

county well located

LANDOWNER: TOPANGA FARMS

P.O. Box 367

Shaw, Miss
(mailing address)

description of formations encountered

from

to

CLAY	0	42
Fine SAND	42	56
SAND & GRAVEL	56	109

WELL LOCATION:

sec. 33 T 20 N R. 3 E
 1/2 miles E of Sunflower
 (distance) (direction) (nearest town)


elev. 120

CODED

WELL PURPOSE: IRRIGATION
(home, irrigation, municipal, industrial)

WELL COMPLETION DATA:

- (1) diameter (inches) 12"
- (2) total depth (feet) 107
- (3) static water level (feet) 18' below top of ground.
- (4) casing BK. IRON 67'
(material) (depth)
12" if telescope see back.
(size)
- (5) screen 45' 67'
(length) (depth to top)
12 Doer-Gravel
(size) (material)
- (6) pump 40 1800
(HP) (yield gpm)
Diesel
(type power)
- (7) electric log NO
(yes or no)
- (organization running log)
- (8) how well bottom plugged PIATE

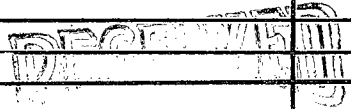


DEC 28 1975

DRILLERS REMARKS:

If well telescopes please sketch and show depths.

GROUND LEVEL

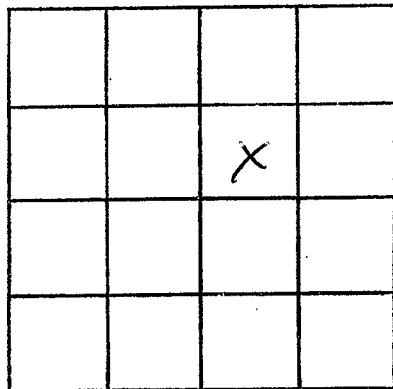

SECTION _____

Please indicate well location X.

ADDITIONAL INFORMATION

If more than one screen,
show locations of each on sketch.