

SUNFLOWER
L 43
4-2-77

MISSISSIPPI
 BOARD OF WATER COMMISSIONERS
 416 North State Street
 Jackson, Mississippi 39201

WATER WELL DRILLERS LOG

CODED

4-2-77 19 BUTANE GAS CO. OF GREENWOOD Sunflower
 date well completed firm name county well located

LANDOWNER:
William Tackett
Schlater
 (mailing address)

description of formations encountered	from	to
CLAY	0	20
SAND	20	30
SAND & GRAVEL	30	93

WELL LOCATION:
 sec. 14 T. 28 N. R. 3 E
3 miles S.E. of Blaine
 (distance) (direction) (nearest town)

WELL PURPOSE: IRR.
 (home, irrigation, municipal, industrial)

CODED

- WELL COMPLETION DATA:**
- diameter (inches) 16"
 - total depth (feet) _____
 - static water level (feet) 18 below above top of ground.
 - casing Steel (material), (depth) _____
16" (size) If telescope see back.
 - screen 40 (length), (depth to top) _____
16" (size), Steel (material)
 - pump 60 (HP), 3000 (yield gpm)
Diesel (type power)
 - electric log No (yes or no)
- (organization running log) _____
- (8) how well bottom plugged Steel Plate

RECEIVED


APR 18 1977

DRILLERS REMARKS:

MISS. BD. OF WATER COMM

If well telescopes please sketch and show depths.

GROUND LEVEL

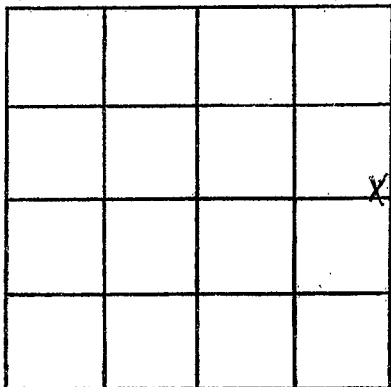

SECTION 14

Please indicate well location X.

ADDITIONAL INFORMATION

If more than one screen, show locations of each on sketch.