

SUNFLOWER  
L 44  
4-7-77

MISSISSIPPI  
BOARD OF WATER COMMISSIONERS  
416 North State Street  
Jackson, Mississippi 39201

CODED

WATER WELL DRILLERS LOG

4-7-77 19 BUTANE GAS CO. OF GREENWOOD Sunflower  
date well completed firm name county well located

LANDOWNER:  
P.C. Nichols  
Doddsville  
(mailing address)

description of formations encountered	from	to
	CLAY	0
SAND	40	60
SAND & GRAVEL	60	93

WELL LOCATION:  
sec. 4 T 20 N R 3 W  
2 miles SE of BLAIR  
(distance) (direction) (nearest town)

CODED

WELL PURPOSE: FRR  
(home, irrigation, municipal, industrial)

WELL COMPLETION DATA:

(1) diameter (inches) 16"

(2) total depth (feet) 93

(3) static water level (feet) 18 below top of ground.

(4) casing Steel 53 (material) (depth)  
16" (size) if telescope see back.

(5) screen 40' 53 (length) (depth to top)  
16" Steel (size) (material)

(6) pump 60 3000 (HP) (yield gpm)  
Diesel (type power)

(7) electric log No (yes or no)

(organization running log)

(8) how well bottom plugged Steel Plate


RECEIVED

APR 18 1977

DRILLERS REMARKS:

If well telescopes please sketch and show depths.

GROUND LEVEL

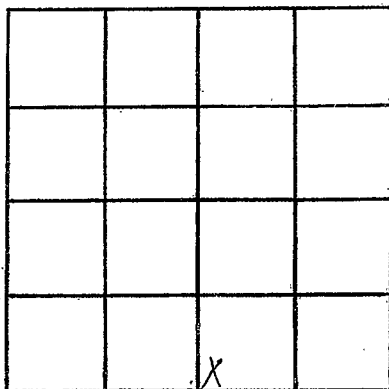

SECTION 15

Please indicate well location X.

ADDITIONAL INFORMATION

If more than one screen, show locations of each on sketch.