

SUNFLOWER
L45
5/3/79
Elog #67

MISSISSIPPI
BOARD OF WATER COMMISSIONERS
416 North State Street
Jackson, Mississippi 39201

CODED

WATER WELL DRILLERS LOG

May 3 19 79 Bruce Berryman - Sunflower
date well completed firm name county well located

LANDOWNER: TOPANGA FARMS	description of formations encountered	from	to
Box 367, Shaw, MS. 38773	Clay	0	20
	Sand	20	80
(mailing address)	Sand & gravel	80	120
	Clay	120	140
WELL LOCATION:	Sand	140	260
sec. 31 T20 N R 3 E	Shale	260	300
3 miles NW of SUNFLOWER	Sandy shale	300	380
(distance) (direction) (nearest town)	Sand CODED	380	400
WELL PURPOSE: Home	Shale & str. sand	400	430
(home, irrigation, municipal, industrial)	Sand	430	450
WELL COMPLETION DATA:	Clay	450	540
(1) diameter (inches) 4" x 2"	Sandy shale	540	560
(2) total depth (feet) 713 ft.	Clay	560	600
(3) static water level (feet) 20 below top of ground.	Fine sand	600	680
(4) casing 4" blk. - 126'	Clay	680	700
2" galv. - 567'	Sand	700	710
(material) (depth)	Clay	710	720
if telescope see back.	Sand & Str. Clay	720	760
(size) 10' 703'	Clay	760	830
(5) screen 10' 683'	Sand	830	840
(length) (depth to top)	Clay	840	870
.010, Stainless steel	Sand & Str. clay	870	900
(size) (material)	Clay	900	920
(6) pump 1 1/2 35	Sandy shale	920	940
(HP) (yield gpm)	Shale	940	970
Electric	Sandy shale	970	1000
(type power)	Clay	1000	1010
(7) electric log Yes	Sandy shale	1010	1035
(yes or no)			
Miss. Geo. Survey.			
(organization running log)			
B.P.V.			
(8) how well bottom plugged			

DRILLERS REMARKS: Altho we drilled to 1035 the only good sand was at 700' and 680' hence the split screen.


Miss. Board of Water Comm.

AUG 20 1979

RECEIVED

If well telescopes please sketch and show depths.

GROUND LEVEL

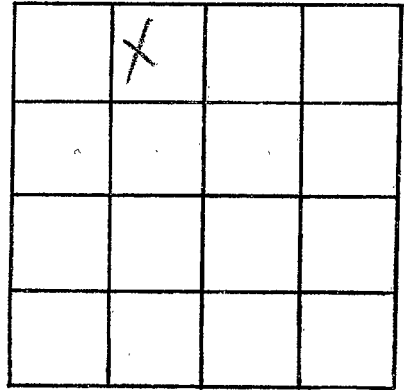

SECTION 31

Please indicate well location X.

ADDITIONAL INFORMATION

If more than one screen,
show locations of each on sketch.