

SUNFLOWER  
L46  
9/12/79

MISSISSIPPI  
BOARD OF WATER COMMISSIONERS  
416 North State Street  
Jackson, Mississippi 39201

CODED

WATER WELL DRILLERS LOG

9-12 date well completed      19 29 Dyer Well + Irrigation firm name      Sunflower county well located

LANDOWNER: TURNER ARANT

SUNFLOWER - (BLAINE)  
(mailing address)

WELL LOCATION:  
sec. 18 T-20 N R-3 E  
2 miles SW of Blaine  
(distance) (direction) (nearest town)

WELL PURPOSE: Irrigation  
(home, irrigation, municipal, industrial)

- WELL COMPLETION DATA:
- (1) diameter (inches) 16"
  - (2) total depth (feet) 109'
  - (3) static water level (feet) 18' below top of ground
  - (4) casing Steel, 69' (material) (depth)  
16" (size) if telescope see back.
  - (5) screen 40', 69' (length) (depth to top)  
16" (size) Steel (material)
  - (6) pump 40 (HP) 2000 (yield gpm)  
Diesel (type power)
  - (7) electric log No (yes or no)  
(organization running log)
  - (8) how well bottom plugged Plate


description of formations encountered	from	to
Clay	0	28
Fine sand	28	35
Sand	35	48
Sand & Gravel	48	109
CODED		

Red DM  
9-24-79

DRILLERS REMARKS:

If well telescopes please sketch and show depths.

GROUND LEVEL

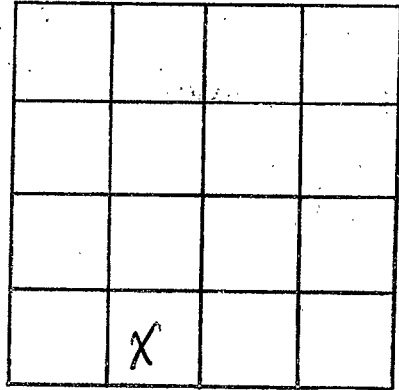

SECTION 18

Please indicate well location X.

ADDITIONAL INFORMATION

A series of horizontal lines for writing additional information.

If more than one screen, show locations of each on sketch.