

SUNFLOWER

L 48

8/8/79

MISSISSIPPI BOARD OF WATER COMMISSIONERS  
416 North State Street  
Jackson, Mississippi 39201

CODED

WATER WELL DRILLERS LOG

8/8/79  
date well completed

19 DYER WELL & IRR  
firm name

SUNFLOWER  
county well located


LANDOWNER:	description of formations encountered	from	to
FRED FISACKERLY SUNFLOWER (mailing address)			
WELL LOCATION:	FINE SAND	28	38
sec. 26 T. <del>20</del> N R. 3 E	SAND	38	46
4 20 S miles N.E. of SUNFLOWER (distance) (direction) (nearest town)	SAND & GRAVEL	46	106
WELL PURPOSE: IRRIGATION (home, irrigation, municipal, industrial)			
WELL COMPLETION DATA:			
(1) diameter (inches) 16			
(2) total depth (feet) 106			
(3) static water level (feet) 19 <sup>below</sup> top of ground.			
(4) casing STEEL, 66' (material) (depth)			
16' if telescope see back. (size)			
(5) screen 40', 66' (length) (depth to top)			
16' STEEL (size) (material)			
(6) pump 40 1800-2000 (HP) (yield gpm)			
DIESEL (type power)			
(7) electric log N (yes or no)			
(organization running log)			
(8) how well bottom plugged PLATE			
DRILLERS REMARKS:			

CODED

Handwritten signature/initials

If well telescopes please  
sketch and show depths.

GROUND LEVEL

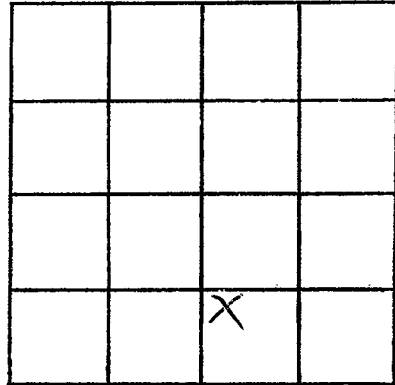

SECTION 26

Please indicate well location X.

ADDITIONAL INFORMATION

If more than one screen,  
show locations of each on sketch.