

GW 6422  
NW/SE, Sec. 8

Elev. 124

SUNFLOWER  
L49  
7/21/79

MISSISSIPPI  
BOARD OF WATER COMMISSIONERS  
416 North State Street  
Jackson, Mississippi 39201

CODED

WATER WELL DRILLERS LOG

7/21 1979 DYEER WELC + IRR SUNFLOWER  
date well completed firm name county well located

LANDOWNER:  
JAMES HOLEMAN  
BLAINE  
(mailing address)

description of formations encountered	from	to
CLAY	0	50
FINE SAND	50	58
SAND + GRAVEL	58	103

WELL LOCATION:  
sec. 8 T. 20 N R. 3 E  
S W (W)  
1/2 miles W of BLAINE  
(distance) (direction) (nearest town)

CODED

WELL PURPOSE:  
(home, irrigation, municipal, industrial)

- WELL COMPLETION DATA:
- (1) diameter (inches) 12"
  - (2) total depth (feet) 103
  - (3) static water level (feet) 21' below top of ground.
  - (4) casing STEEL, 63' (material) (depth)
  - 12" (size) if telescope see back.
  - (5) screen 40' length, 63' (depth to top)
  - 12" STEEL (size) (material)
  - (6) pump 25 HP, 1500-1800 (yield gpm)
  - ELECTRIC (type power)
  - (7) electric log NO (yes or no)

(organization running log)

(8) how well bottom plugged PLATE

DRILLERS REMARKS:

DEPT. OF NATURAL RESOURCES  
BUREAU OF LAND & WATER RESOURCES

OCT 29 1979


RECEIVED

If well telescopes please sketch and show depths.

---

GROUND LEVEL

---

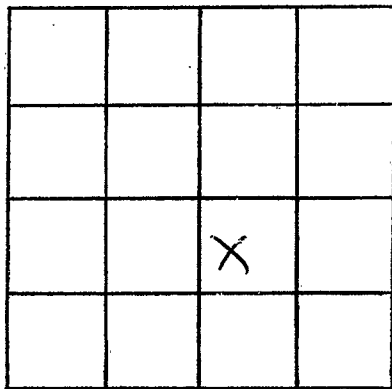

SECTION 8

Please indicate well location X.

ADDITIONAL INFORMATION

---

---

If more than one screen, show locations of each on sketch:

---