

SUNFLOWER
L-50
6-2-79

MISSISSIPPI
BOARD OF WATER COMMISSIONERS
416 North State Street
Jackson, Mississippi 39201

CODED

WATER WELL DRILLERS LOG

6/2/79 19 DYER-WELL + IRR SUNFLOWER
date well completed firm name county well located

LANDOWNER:
PAUL NICHOLS
BLAINE
(mailing address)
WELL LOCATION:
sec. 16 T. 20 N. R. 3 E
S W
1/2 miles SE of BLAINE
(distance) (direction) (nearest town)

description of formations encountered	from	to
CLAY	0	28
FINE SAND	28	35
SAND	35	65
SAND + GRAVEL	65	100

WELL PURPOSE:
(home, irrigation, municipal, industrial)

- WELL COMPLETION DATA:
- (1) diameter (inches) 16
 - (2) total depth (feet) 100
 - (3) static water level (feet) 20 below top of ground.
 - (4) casing STEEL 60 (material), (depth)
16 if telescope see back. (size)
 - (5) screen 40 60 (length) (depth to top)
16 STEEL (size) (material)
 - (6) pump 60 3000 (HP) (yield gpm)
ELECTRIC (type power)
 - (7) electric log NO (yes or no)

(organization running log)
(8) how well bottom plugged PLATE

DRILLERS REMARKS:


DEPT. OF NATURAL RESOURCES
BUREAU OF LAND & WATER RESOURCES

NOV 13 1979

RECEIVED

If well telescopes please sketch and show depths.

GROUND LEVEL

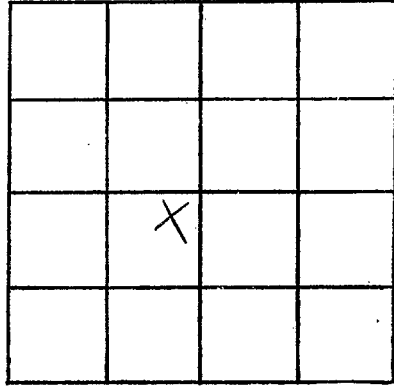

SECTION 16

Please indicate well location X.

ADDITIONAL INFORMATION

Lined area for additional information.

If more than one screen, show locations of each on sketch.