

MISSISSIPPI DEPARTMENT OF NATURAL RESOURCES

Bureau of Land and Water Resources

Southport Mall

P.O. Box 10631

CODED

Jackson, Mississippi 39209

WATER WELL DRILLERS LOG

SUNFLOWER
L 51
5-27-80

5/27/80 date well completed 19 80 DYER WELL + IRR firm name SUNFLOWER county well located

LANDOWNER:	description of formations encountered	from	to
DR WALTER ROSE 601 MAGNOLIA IXIDIANOLA, MISS. 38751 (mailing address)	CLAY	0	28
	FINE SAND	28	38
	SAND	38	54
	SAND + GRAVEL	54	112
WELL LOCATION: sec. 33 T. 20 N. R. 3 E 1 1/2 miles NE of SUNFLOWER (distance) (direction) (nearest town)			
WELL PURPOSE: (home, Irrigation, municipal, industrial)			
WELL COMPLETION DATA:			
(1) diameter (inches) 16			
(2) total depth (feet) 112			
(3) static water level (feet) 22 below top of ground.			
(4) casing STEEL 72 (material), (depth) 16 (size) if telescope see back.			
(5) screen 40 72 (length) (depth to top) 16 STEEL (size) (material)			
(6) pump 60 2800 (HP) (yield gpm) DIESEL (type power)			
(7) electric log NO (yes or no)			
(organization running log)			
(8) how well bottom plugged STEEL PLATE			

CODED

DEPT. OF NATURAL RESOURCES  
BUREAU OF LAND & WATER RESOURCES


OCT 14 1980

RECEIVED

DRILLERS REMARKS:

If well telescopes please sketch and show depths.

GROUND LEVEL

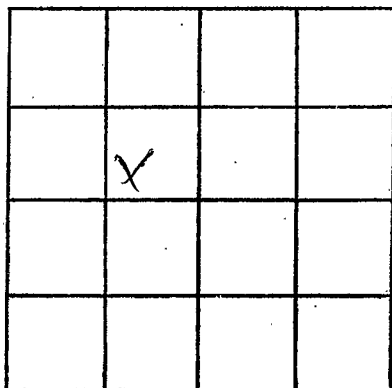

SECTION

33

Please indicate well location X.

ADDITIONAL INFORMATION

If more than one screen, show locations of each on sketch.