

SUNFLOWER
L 52
4-29-81

MISSISSIPPI DEPARTMENT OF NATURAL RESOURCES
Bureau of Land and Water Resources
Southport Mall
P.O. Box 10631
Jackson, Mississippi 39209
WATER WELL DRILLERS LOG

CODED

4-29 1981 date well completed
Dyer Well & Inc. firm name
Sunflower county well located

LANDOWNER: Turner Arant

description of formations encountered	from	to
Clay	13	23
Clay	23	33
Clay	33	42
slt	43	53
slt	53	62
granular	63	73
granular	73	83
granular	83	93
granular	93	103
granular	103	113

Blaine (mailing address)

WELL LOCATION:
sec. 18 T 20 N R 3 E S W
2 miles E of Blaine
(distance) (direction) (nearest town)

WELL PURPOSE:
(home, irrigation, municipal, industrial)

WELL COMPLETION DATA:

- (1) diameter (inches) 16"
- (2) total depth (feet) 113'
- (3) static water level (feet) 19' below top of ground.
- (4) casing Steel, 113' (material), (depth)
- (5) screen 16" if telescope see back., 40' length, 73' depth to top (size), (material)
- (6) pump 60 HP, 2000 yield gpm (type power)
- (7) electric log No (yes or no)
- (8) how well bottom plugged plate (organization running log)


DRILLERS REMARKS:

DEPT. OF NATURAL RESOURCES
BUREAU OF LAND & WATER RESOURCES

MAY 19 1981
RECEIVED

If well telescopes please sketch and show depths.

GROUND LEVEL

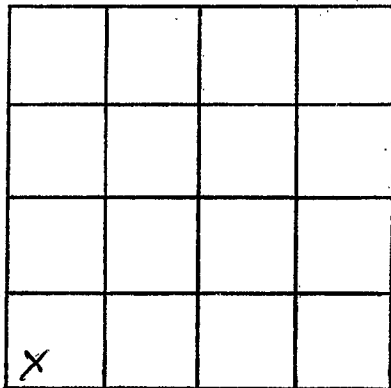

SECTION 18

Please indicate well location X.

ADDITIONAL INFORMATION

If more than one screen, show locations of each on sketch.