

MISSISSIPPI DEPARTMENT OF NATURAL RESOURCES

Bureau of Land and Water Resources

Southport Mall

P.O. Box 10631

Jackson, Mississippi 39209

WATER WELL DRILLERS LOG

CODED

SUNFLOWER

L 53

5-8-81

5-8-81
date well completed

19 *Dyersville & Surge Sunflower*
firm name county well located

LANDOWNER:

D E Bright

description of formations encountered

from

to

Daddsville, Miss.

(mailing address)

*Clay
lime sand
Sand*

0

30

30

36

36

48

WELL LOCATION:

sec. 20 T 20 (N) R 3 E
S
1 miles S of Blaine
(distance) (direction) (nearest town)

Sand + Gravel

48

103

CODED

WELL PURPOSE:

(home, irrigation, municipal, industrial)

WELL COMPLETION DATA:

- (1) diameter (inches) 12"
- (2) total depth (feet) 103"
- (3) static water level (feet) 19' below above top of ground.
- (4) casing Steel, 103'
(material) (depth)
12" if telescope see back.
(size)
- (5) screen 40', 63'
(length) (depth to top)
12", Steel
(size) (material)
- (6) pump 40 2000
(HP) (yield gpm)
Propane
(type power)
- (7) electric log No
(yes or no)

(organization running log)

- (8) how well bottom plugged plate

DRILLERS REMARKS:


DEPT. OF NATURAL RESOURCES
BUREAU OF LAND & WATER RESOURCES

MAY 19 1981

RECEIVED

If well telescopes please sketch and show depths.

GROUND LEVEL

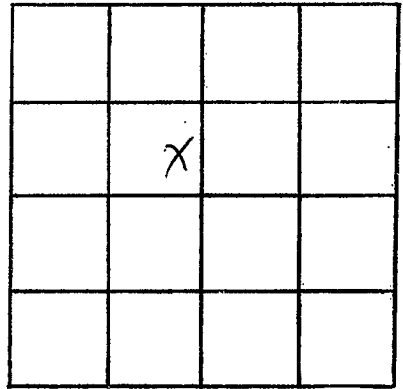

SECTION 20

Please indicate well location X.

ADDITIONAL INFORMATION

If more than one screen, show locations of each on sketch.