

MISSISSIPPI DEPARTMENT OF NATURAL RESOURCES

Bureau of Land and Water Resources

Southport Mall

P.O. Box 10631

Jackson, Mississippi 39209

WATER WELL DRILLERS LOG

0082  
CODED

Sunflower  
L 55  
2-20-81

2/20 1981  
date well completed

Dyer  
owner name

Sum.  
county well located

LANDOWNER:

FRED FISACKLEY

Sunflower, MS.  
(mailing address)

WELL LOCATION:

sec. 14 T-20N R-3E  
3 miles E of Plane  
(distance) (direction) (nearest town)

WELL PURPOSE:

(home, irrigation, municipal, industrial)

WELL COMPLETION DATA:

(1) diameter (inches) 16"  
(2) total depth (feet) 104'  
(3) static water level (feet) 22' below top of ground.

(4) casing (material) Steel (depth) 104'

16" If telescopic see back.  
(size)

(5) screen (length) 40' (depth to top) 64'

16" Steel  
(size) (material)

(6) pump (HP) 60 (yield gpm) 3000

diesel  
(type power)

(7) electric log (yes or no)

(organization running log)


(8) how well bottom plugged *slate*

description of formations encountered


from to

Clay	0	28
fine sand	18	28
sand	28	40
sand + gravel	40	104
Clay		

CODED

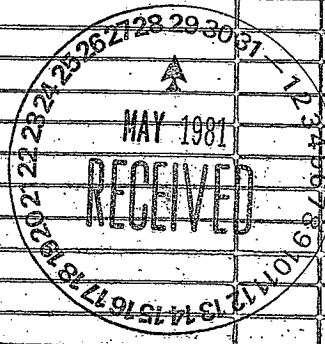

DRILLERS REMARKS:

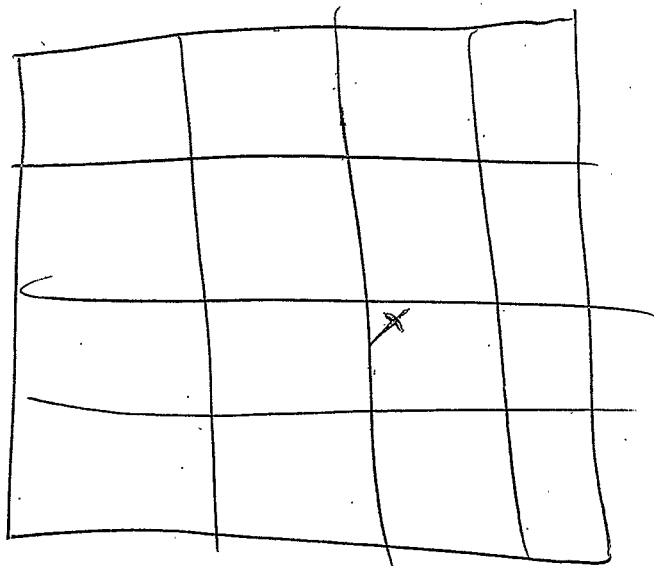

Sec 14