

MISSISSIPPI DEPARTMENT OF NATURAL RESOURCES

Bureau of Land and Water Resources

Southport Mall

P.O. Box 10631

Jackson, Mississippi 39209

WATER WELL DRILLERS LOG

009/  
CODED

Sunflower  
L56  
2-25-81

2/25/81  
date well completed

Dyer  
firm name

Sum  
county well located

LANDOWNER:  
MAURY MCINTYRE  
Doddsville MS.  
(mailing address)

description of formations encountered	from	to
Clay	0	12
2 in sand	12	32
Shale + Clay	32	57
Clay	57	68
Sand	68	75
Sand + gravel	75	113


WELL LOCATION:  
sec. 4 T 200 R 3 E  
2 S  
(distance) miles (direction) of Doddsville (nearest town)

WELL PURPOSE:  
(home, irrigation, municipal, industrial)

WELL COMPLETION DATA:

- (1) diameter (inches) 16
- (2) total depth (foot) 113'
- (3) static water level (foot) 21' below top of ground.
- (4) casing Steel 113' (material) (depth)  
16" (size) if telescope see back.
- (5) screen 40' 23' (length) (depth to top)  
16" Steel (size) (material)
- (6) pump 60 3000 (HP) (yield gpm)  
Diesel (type power)
- (7) electric log (yes or no)
- (organization running log)
- (8) how well bottom plugged plate

CODED

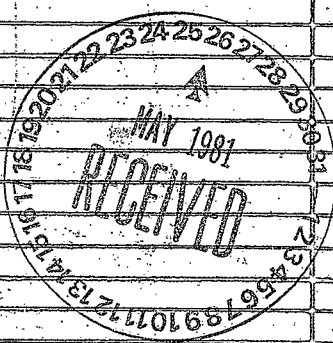

DRILLERS REMARKS:

A hand-drawn 4x4 grid. The grid is slightly skewed to the right. An 'X' is drawn in the second row, second column from the top-left.

	X		

Sec 4