

Bureau of Land and Water Resources

Southport Mall

P.O. Box 10631

Jackson, Mississippi 39209

WATER WELL DRILLERS LOG CODED

Sun Flower  
L 57  
2-28-81

109

2/28 1981 date well completed  
Dyer firm name  
Sun county well located

LANDOWNER:  
SUPT ED SUNFLOWER CO  
  
(mailing address)


description of formations encountered	from	to
Clay	8	28
Fine Sand	28	38
Sand	38	53
Scrub gravel	53	93

WELL LOCATION:  
sec 8 T 20 S R 3 E  
1/2 miles N of Plane  
(distance) (direction) (nearest town)


WELL PURPOSES:  
(home, irrigation, municipal, industrial)

CODED

- WELL COMPLETION DATA:
- (1) diameter (inches) 10
  - (2) total depth (foot) 93
  - (3) static water level (foot) 20 below top of ground
  - (4) casing Steel 93  
(material) (depth)  
10 if telescopic see back.  
(size)
  - (5) screen 40 53  
(length) (depth to top)  
10 Steel  
(size) (material)
  - (6) pump 10 1000  
(HP) (yield gpm)  
Electric  
(type power)
  - (7) electric log (yes or no)
  - (organization running log)
  - (8) how well bottom plugged plate

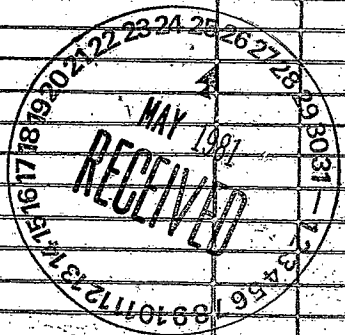

DRILLERS REMARKS:

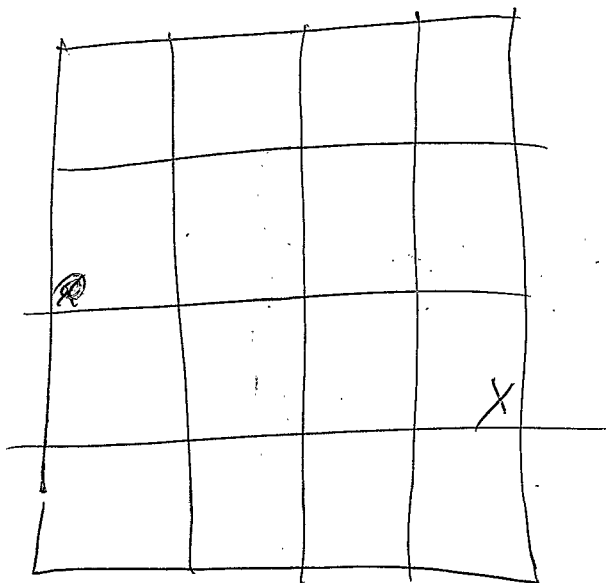

See 8