

Sunflower
L58
2-15-80

MISSISSIPPI
 BOARD OF WATER COMMISSIONERS
 416 North State Street
 Jackson, Mississippi 39201

CODED

WATER WELL DRILLERS LOG

2/15 1980 Dyer Sum.
 date well completed firm name county well located

LANDOWNER:
MAURY MCINTYRE
DODDSVILLE, MS.
 (mailing address)


description of formations encountered	from	to
<u>Clay</u>	<u>0</u>	<u>28</u>
<u>Fine Sand</u>	<u>28</u>	<u>38</u>
<u>Sand</u>	<u>38</u>	<u>48</u>
<u>Sand & Gravel</u>	<u>48</u>	<u>123</u>

WELL LOCATION:
 sec. 4 T. 20 N. R. 3 E.
2 miles S of Doddsville
 (distance) (direction) (nearest town)

WELL PURPOSE:
 (home, irrigation, municipal, industrial)

CODED


- WELL COMPLETION DATA:
- (1) diameter (inches) 16"
 - (2) total depth (feet) 113'
 - (3) static water level (feet) 20' below top of ground.
 - (4) casing Steel, 113'
 (material) (depth)
16" if telescope see back.
 (size)
 - (5) screen 40' 73'
 (length) (depth to top)
1/2" Steel
 (size) (material)
 - (6) pump 60 3000
 (HP) (yield gpm)
Diesel
 (type power)
 - (7) electric log (yes or no) _____
 (organization running log) _____
 - (8) how well bottom plugged plate

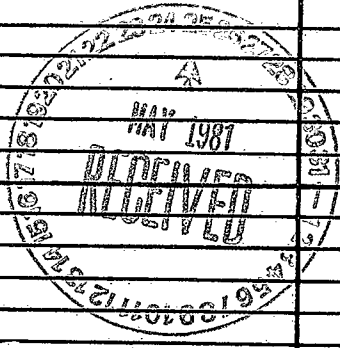

DRILLERS REMARKS:

If well telescopes please sketch and show depths.

GROUND LEVEL

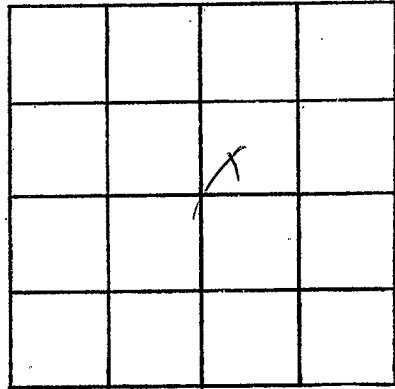

SECTION 4

Please indicate well location X.

ADDITIONAL INFORMATION

If more than one screen,
show locations of each on sketch.