

Sunflower
L59
3-24-80

MISSISSIPPI
 BOARD OF WATER COMMISSIONERS
 416 North State Street
 Jackson, Mississippi 39201

CODED

WATER WELL DRILLERS LOG

3/24 1980 Dyer Sumner
 date well completed firm name county well located

LANDOWNER:
FREDDIE FISACKLEY
SUNFLOWER, MS.
 (mailing address)

description of formations encountered	from	to
<u>Clay</u>	<u>0</u>	<u>28</u>
<u>fine sand</u>	<u>28</u>	<u>38</u>
<u>sand</u>	<u>38</u>	<u>49</u>
<u>sand & gravel</u>	<u>49</u>	<u>110</u>


WELL LOCATION:
 sec. 14 T 20 N R 3 E
3 miles S of Dodderville
 (distance) (direction) (nearest town)

WELL PURPOSE:
 (home, irrigation, municipal, industrial)

- WELL COMPLETION DATA:
- (1) diameter (inches) 1 1/2"
 - (2) total depth (feet) 110'
 - (3) static water level (feet) 21' below top of ground.
 - (4) casing Steel, 110'
 (material) (depth)
16" if telescope see back.
 (size)
 - (5) screen 40', 70'
 (length) (depth to top)
16", Steel
 (size) (material)
 - (6) pump 60, 3000
 (HP) (yield gpm)
Diesel
 (type power)
 - (7) electric log
 (yes or no)

 (organization running log)
 - (8) how well bottom plugged plate


CODED

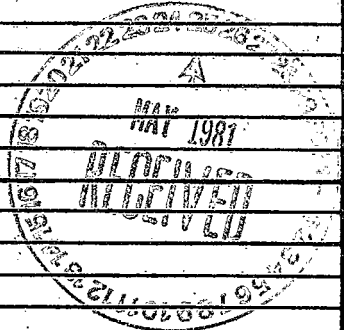

DRILLERS REMARKS:

If well telescopes please sketch and show depths.

GROUND LEVEL

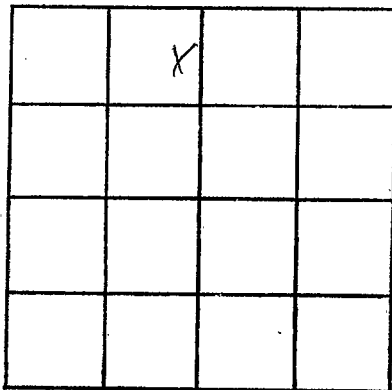

SECTION 14

Please indicate well location X.

ADDITIONAL INFORMATION

If more than one screen, show locations of each on sketch.

Champion 101 CTS