

Sun Flower
L60
3-24-80

MISSISSIPPI
BOARD OF WATER COMMISSIONERS
416 North State Street
Jackson, Mississippi 39201

CODED

WATER WELL DRILLERS LOG

3/24 1980 date well completed
Dyer firm name
Sun county well located

LANDOWNER:
FREDDIE FISACKLEY
SUNFLOWER MS
(mailing address)

description of formations encountered	from to	
Clay	0	28
fine sand	28	38
sand	38	48
small gravel	48	101

WELL LOCATION:
sec. 4 T. 20 N. R. 3 E.
S W
3 miles S of Doddsville
(distance) (direction) (nearest town)

WELL PURPOSE:
(home/irrigation, municipal, industrial)

WELL COMPLETION DATA:

(1) diameter (inches) 16"

(2) total depth (feet) 101'

(3) static water level (feet) 21' below top of ground.

(4) casing Steel 101'
(material) (depth)
16" if telescope see back.
(size)

(5) screen 40' 61'
(length) (depth to top)
16" Steel
(size) (material)


(6) pump 60 3000
(HP) (yield gpm)
Diesel
(type power)

(7) electric log (yes or no)

(organization running log)

(8) how well bottom plugged slate


CODED

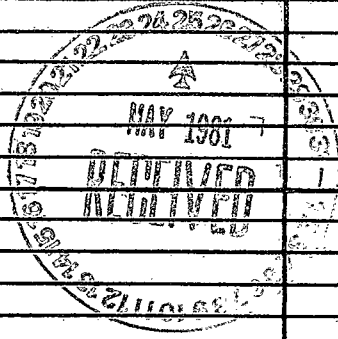

DRILLERS REMARKS:

If well telescopes please sketch and show depths.

GROUND LEVEL

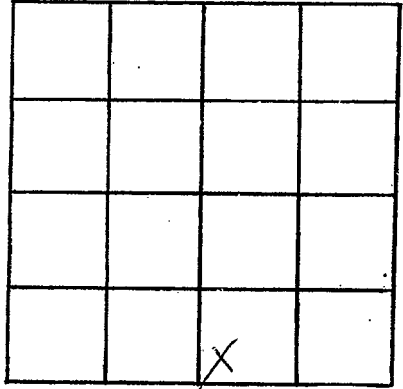

SECTION 14

Please indicate well location X.

ADDITIONAL INFORMATION

If more than one screen,
show locations of each on sketch.