

MISSISSIPPI DEPARTMENT OF NATURAL RESOURCES

Bureau of Land and Water Resources

Southport Mall

P.O. Box 10631

Jackson, Mississippi 39209

WATER WELL DRILLERS LOG

3319
CODED

Sunflower

LC1

11-13-80

11/13 1980
date well completed

Dym
firm name

Sun
county well located

LANDOWNER:

DAVID FREEMAN

description of formations encountered from to

SUNFLOWER, MS.
(mailing address)

0'-20' top soil
20'-50' sand
50'-103' sand & gravel

WELL LOCATION:

sec. 24 T 200 R 3 E
S W
4 miles SE of Blaine
(distance) (direction) (nearest town)

WELL PURPOSE:


(home, irrigation, municipal, industrial)

CODED

WELL COMPLETION DATA:

- (1) diameter (inches) 16
- (2) total depth (feet) 103'
- (3) static water level (feet) 20' below top of ground.
- (4) casing (material) (depth) 103'
16" if telescopic see back.
- (5) screen (length) (depth to top) 40' 63'
16" (size) (material) Steel
- (6) pump (HP) (yield gpm) 60 3000
Diesel (type power)
- (7) electric log (yes or no)
- (organization running log)
- (8) how well bottom plugged plate

DRILLERS REMARKS:

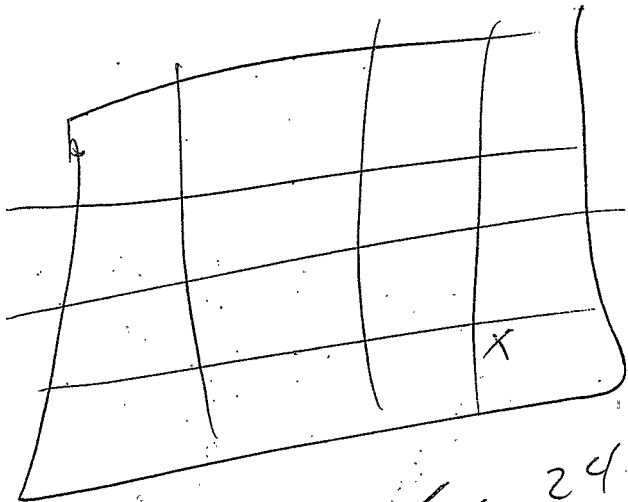

Sec 24
