

MISSISSIPPI DEPARTMENT OF NATURAL RESOURCES

Bureau of Land and Water Resources

Southport Mall

P.O. Box 10631

Jackson, Mississippi 39209

WATER WELL DRILLERS LOG

CODED

Sunflower
L62
5-17-81


5-17-1981
date well completed

Dyer Well
firm name

Sunflower
county/well located


LANDOWNER:	description of formations encountered	from	to
Holly Ridge Ag. Co. (mailing address)	clay sand & gravel	0 30	30 102
WELL LOCATION: sec. <u>1</u> T <u>200</u> S R. <u>3</u> E <u>3</u> miles <u>E</u> of <u>Blaine</u> (distance) (direction) (nearest town)			
WELL PURPOSE: (home, irrigation, municipal, industrial)			
WELL COMPLETION DATA: (1) diameter (inches) <u>16"</u> (2) total depth (feet) <u>102'</u> (3) static water level (feet) <u>20'</u> below above top of ground. (4) casing <u>Steel</u> , <u>102'</u> , (material) (depth) <u>16"</u> if telescope see back. (size) (5) screen <u>40'</u> , <u>62'</u> (length) (depth to top) <u>16"</u> , <u>Steel</u> (size) (material) (6) pump <u>60</u> , <u>3000</u> (HP) (yield gpm) <u>Diesel</u> (type power) (7) electric log _____ (yes or no) _____ (organization running log) (8) how well bottom plugged <u>plate</u>			
DRILLERS REMARKS:			

CODED

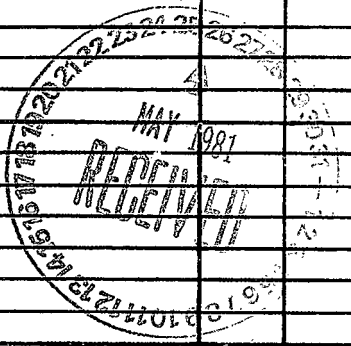

If well telescopes please sketch and show depths.

GROUND LEVEL

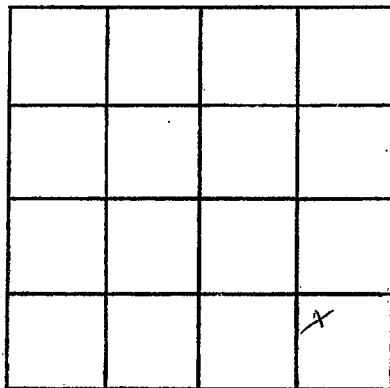

SECTION 1

Please indicate well location X.

ADDITIONAL INFORMATION

If more than one screen,
show locations of each on sketch.