

Sunflower
L63
3 - - 80

MISSISSIPPI
BOARD OF WATER COMMISSIONERS
416 North State Street
Jackson, Mississippi 39201


CODED

WATER WELL DRILLERS LOG

3/19 80 date well completed
Dyer firm name
Sun county well located

LANDOWNER:	description of formations encountered	from	to
MORGAN BROS			
SUNFLOWER, MS. (mailing address)	Clay fine sand sand	0 28 38	28 38 42
WELL LOCATION: sec. 25 T. 20 N R. 3 E 6 miles NE of Sunflower (distance) (direction) (nearest town)	Sand & Gravel	48	111
WELL PURPOSE: (home, irrigation, municipal, industrial)			
WELL COMPLETION DATA:			
(1) diameter (inches) 16"			
(2) total depth (feet) 111'			
(3) static water level (feet) 20' below top of ground.			
(4) casing Steel 111' (material) (depth) 16" if telescope see back. (size)			
(5) screen 40' 61' (length) (depth to top)			
(6) pump 16" Diesel 60 3000 (size) (material) (HP) (yield gpm) (type power)			
(7) electric log _____ (yes or no) (organization running log)			
(8) how well bottom plugged plate			
DRILLERS REMARKS:			

CODED

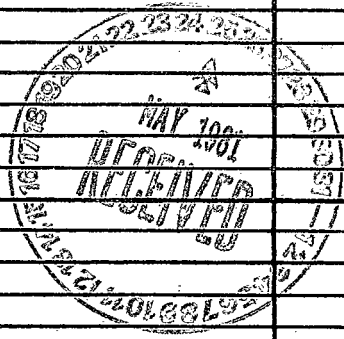

If well telescopes please sketch and show depths.

GROUND LEVEL

	X		

SECTION 25

Please indicate well location X.

ADDITIONAL INFORMATION

If more than one screen,
show locations of each on sketch.