

MISSISSIPPI DEPARTMENT OF NATURAL RESOURCES

Bureau of Land and Water Resources

Southport Mall

P.O. Box 10631

Jackson, Mississippi 39209

CODED

WATER WELL DRILLERS LOG

Amploma
L67
6-30-81

6/30/81
date well completed

Dyer

Holly Ridge Mfg Co.
firm name

Amploma
county well located

LANDOWNER:

Holly Ridge Mfg Co.
Box 95

description of formations encountered

from

to

Indianola, Ms
(mailing address)

<u>sand</u>	<u>13</u>	<u>23</u>
<u>sand</u>	<u>23</u>	<u>33</u>
<u>sand</u>	<u>33</u>	<u>43</u>
<u>gravel</u>	<u>43</u>	<u>53</u>
<u>gravel</u>	<u>53</u>	<u>63</u>
<u>gravel</u>	<u>63</u>	<u>73</u>
<u>sand gravel</u>	<u>73</u>	<u>83</u>
<u>gravel</u>	<u>83</u>	<u>93</u>
<u>salit. rock</u>	<u>93</u>	<u>108</u>

WELL LOCATION:

sec. 1 T 20 N R 3 E
S W
4 miles SE of PODISVILLE
(distance) (direction) (nearest town)

WELL PURPOSE:

(home, irrigation, municipal, industrial)

WELL COMPLETION DATA:


- (1) diameter (inches) 16
- (2) total depth (feet) 113
- (3) static water level (feet) 72 below above top of ground.
- (4) casing Steel (material) (depth) 16 If telescope see back. (size)
- (5) screen 40 (length) (depth to top) (size) (material)
- (6) pump 12" 2000 (HP) (yield gpm)
Orwell (type power)
- (7) electric log NO (yes or no)

(organization running log)

(8) how well bottom plugged Plate

DRILLERS REMARKS:

CODED

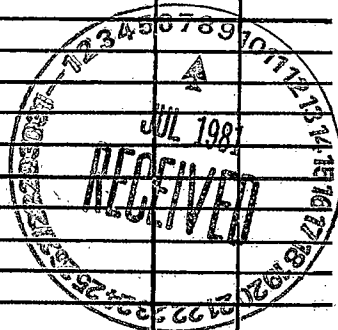


If well telescopes please sketch and show depths.

24.

23.

47

GROUND LEVEL

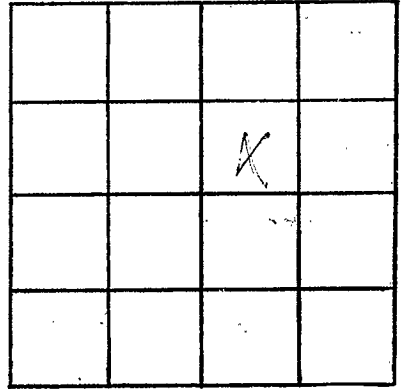

SECTION _____

Please indicate well location X.

ADDITIONAL INFORMATION

2350

1175

3525

If more than one screen, show locations of each on sketch.