

MISSISSIPPI DEPARTMENT OF NATURAL RESOURCES

Bureau of Land and Water Resources

Southport Mall

P.O. Box 10631

Jackson, Mississippi 39209

CODED

WATER WELL DRILLERS LOG

SUNFLOWER
L 70
7/23/81

GW 10473
NW/SE, Sec. 18
Elev. 123

7/23/81
date well completed

Sunflower Drilling
firm name

Sunflower
county well located

LANDOWNER: Turner Arant

description of formations encountered

from

to

WELL LOCATION:

sec. 18 T. 200 N. R. 3 E. W. W
2 miles W of Blaine
(distance) (direction) (nearest town)

WELL PURPOSE:

(home, irrigation, municipal, industrial)

WELL COMPLETION DATA:

- (1) diameter (inches) 16
- (2) total depth (feet) 110'
- (3) static water level (feet) 24' below top of ground
- (4) casing Steel 70'
(material) (depth)
16' if telescope see back.
(size)
- (5) screen 40 70'
(length) (depth to top)
16 Steel
(size) (material)
- (6) pump 40 2000
(HP) (yield gpm)
Diesel
(type power)
- (7) electric log NO
(yes or no)


(organization running log)

- (8) how well bottom plugged Plate

DRILLERS REMARKS:


soil	10	23
soil	23	33
soil	33	43
sand & gravel	43	53
gravel	53	63
gravel	63	73
sand & gravel	73	83
gravel	83	93
hard gravel	93	103
bottom clay & gravel	103	110

CODED

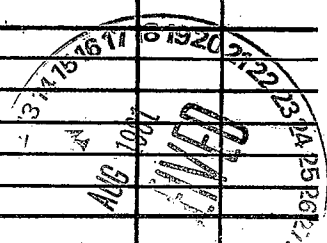

If well telescopes please sketch and show depths.

GROUND LEVEL

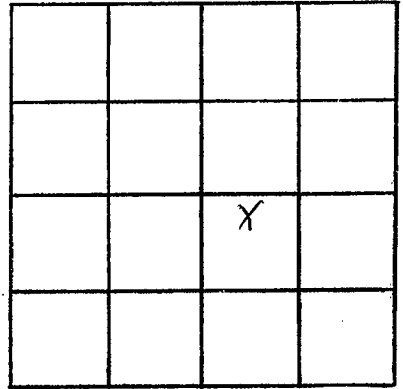

SECTION 18

Please indicate well location X.

ADDITIONAL INFORMATION

If more than one screen,
show locations of each on sketch.