

MISSISSIPPI DEPARTMENT OF NATURAL RESOURCES

Bureau of Land and Water Resources

Southport Mall

P.O. Box 10631

Jackson, Mississippi 39209

WATER WELL DRILLERS LOG

CODED

SUNFLOWER
L 71
7-8-81
7/8/81

date well completed

firm name

county well located

LANDOWNER:

Clayton Knight

description of formations encountered

from

to

Shaddsville, Mo.
(mailing address)

Clay	0	28
Fine Sand	28	37
Sand + Gravel	37	117

WELL LOCATION:

sec. 7 T 20 N R 3 E
S W
2 miles W of Blaine
(distance) (direction) (nearest town)

WELL PURPOSE:

(home, irrigation, municipal, industrial)

CODED


WELL COMPLETION DATA:

- (1) diameter (inches) 16
- (2) total depth (feet) 113'
- (3) static water level (feet) 22' below top of ground.
- (4) casing Steel 73'
(material) (depth)
16 If telescope see back.
(size)
- (5) screen 40' 73'
(length) (depth to top)
16 Steel
(size) (material)
- (6) pump 1/2 3000
(HP) (yield gpm)
Electric
(type power)
- (7) electric log No
(yes or no)

(organization running log)


(8) how well bottom plugged Plate

DRILLERS REMARKS:

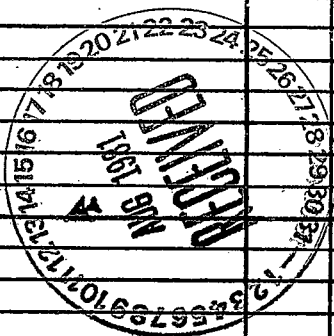

If well telescopes please sketch and show depths.

GROUND LEVEL

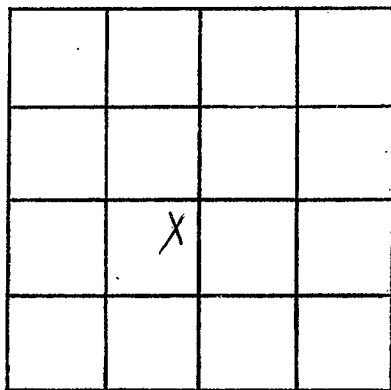

SECTION 2

Please indicate well location X.

ADDITIONAL INFORMATION

If more than one screen,
show locations of each on sketch.